


RASTER

PARENT PARCEL: 15-00-065-000-027

CHILD PARCEL: XX-XX-XXX-XXX-XXX

STARTING POINT: N.W. CORNER OF O.L. 65

NO. 00553-A

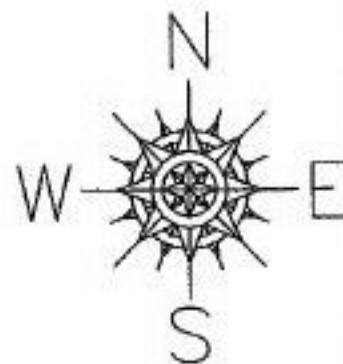

O.L. 56

O.L. 65

642.41

-027

~~6.91 A.~~

4.09 A.

AC. CORR. PER SURV.
DANIEL J. COOK

554.71

849.17

SPLITS/DEEDS PROCESSED

LORAIN COUNTY TAX MAP DEPARTMENT
226 MIDDLE AVE. ELYRIA, OHIO

SURVEYED BY: DANIEL J. COOK

CLOSURE: 0.01 : 10.000

MAP PAGE(S): 15-00-065-A

APPROVED BY: IJS DATE: 5/23/01

SCALE: 1" = 100' PRIOR INSTRUMENT: DV 1017/233