


RASTER

PARENT PARCEL: 03-00-047-103-029 & -030
CHILD PARCEL: XXXXXXXXXXXX
STARTING POINT: XXXXXXXXXXXX

NO. 00554-A

FR. & DEPTH CORR.

03-00-047-103-030
~~88 X 150-200~~
84.38 X 201.19 IRR.
AC. CORR. PER SURV.
MICHAEL A. STRAUB

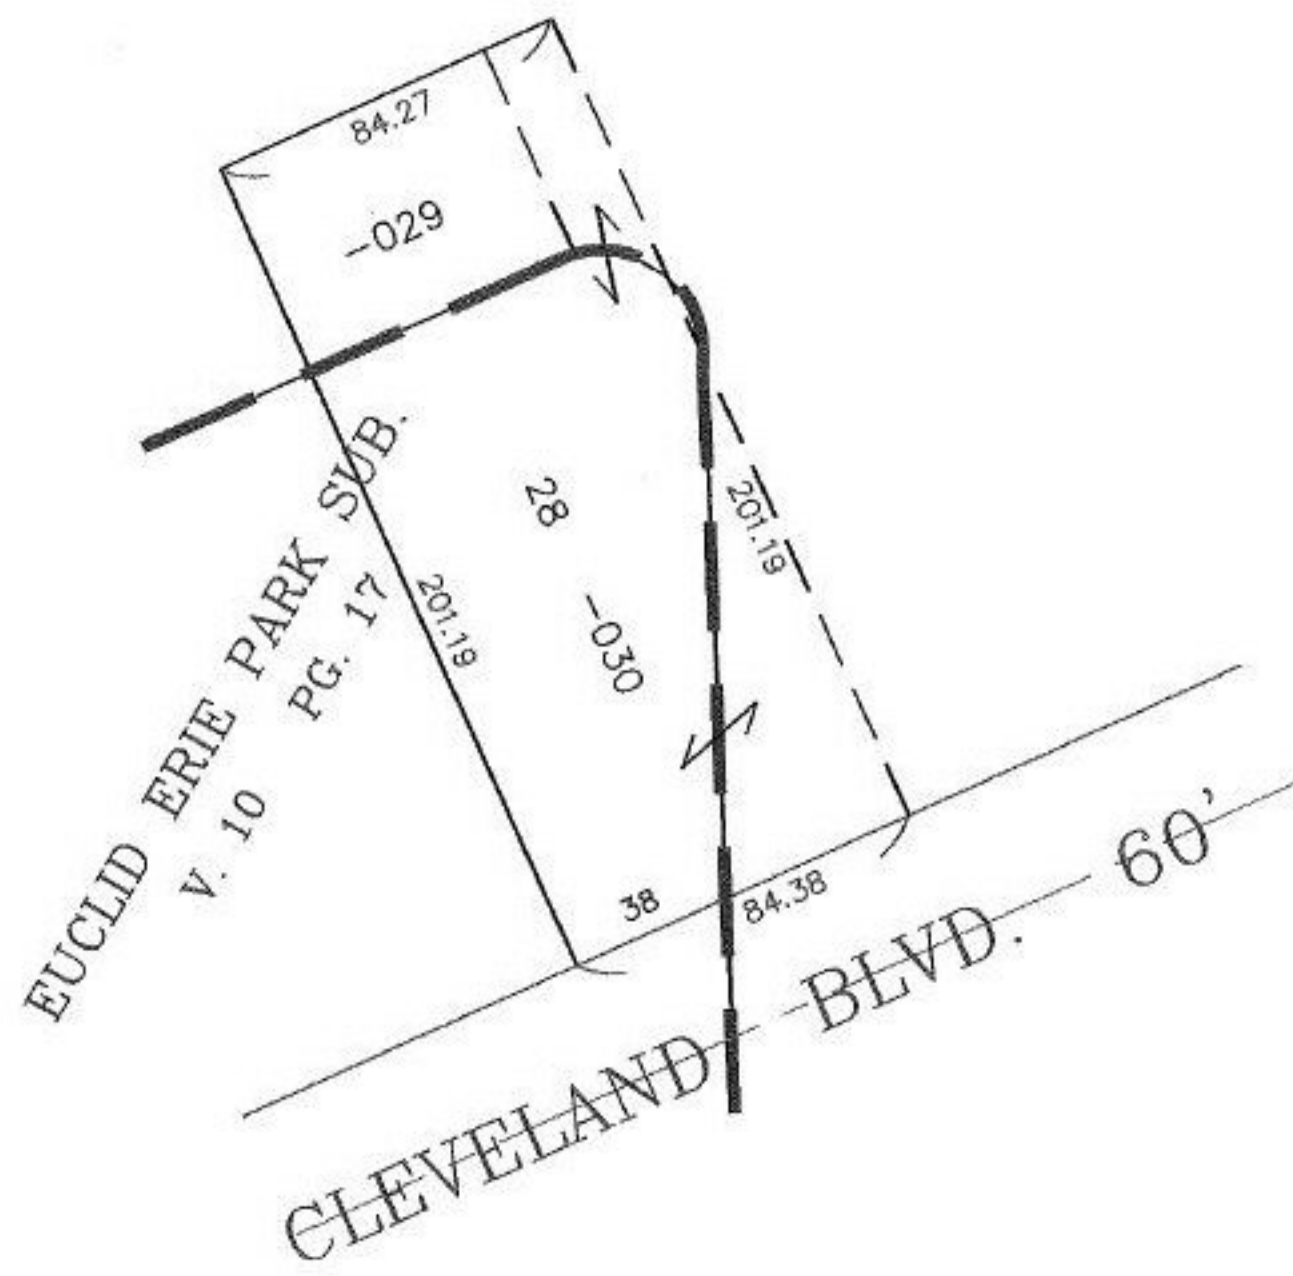

SPLITS/DEEDS PROCESSED
LORAIN COUNTY TAX MAP DEPARTMENT
226 MIDDLE AVE. ELYRIA, OHIO

SURVEYED BY: MICHAEL A. STRAUB
CLOSURE: 0.00 : 10.000
MAP PAGE(S): 3-00-047-A
APPROVED BY: TJS DATE: 5/29/01
SCALE: 1" = 50' PRIOR INSTRUMENT: 990593894