



EASTER

PARENT PARCEL: 04-00-011-106-004

CHILD PARCEL:

STARTING POINT: INTERSECTION OF THE C/L OF BAUERDALE AVE. AND THE C/L STONEY RIDGE RD.

NO. 00564-A

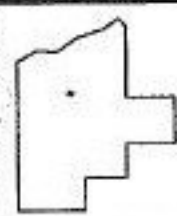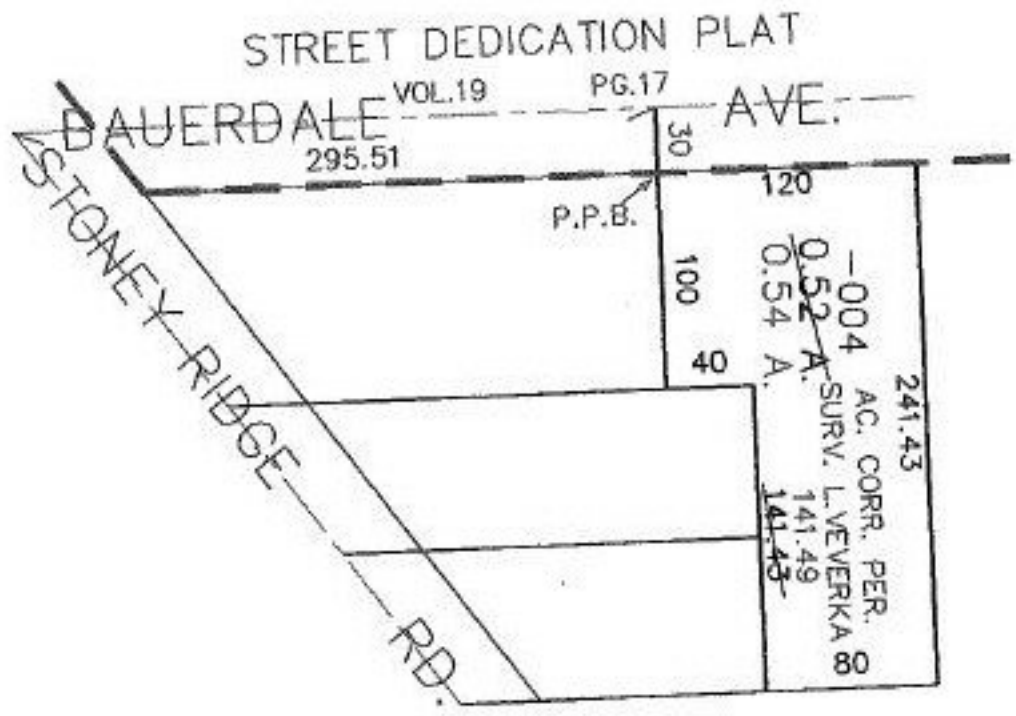

SPLITS/DEEDS PROCESSED

LORAIN COUNTY TAX MAP DEPARTMENT
226 MIDDLE AVE. ELYRIA, OHIO

SURVEYED BY: L. VEVERKA

CLOSURE: 00:10.000

MAP PAGE(S): 4-00-011-D

APPROVED BY: RRM DATE: 6-18-01

SCALE: 1" = 100' PRIOR INSTRUMENT: N/A