PARENT PARCEL: 18-00-021-103-011,-012

CHILD PARCEL:_

STARTING POINT: INTERSECTION OF THE SOUTHERLY LINE OF ADAMS ST. AND S/L 1 OF


ORIGINAL VILLAGE PLAT

PART OF: ORIGINAL VILLAGE PLAT VOL.1 PG.6

NO. 00574-A



ADAMS -

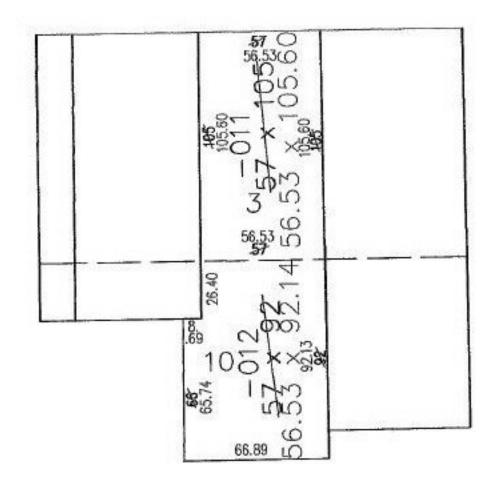

SPLITS/DEEDS PROCESSED LORAIN COUNTY TAX MAP DEPARTMENT 226 MIDDLE AVE. ELYRIA, OHIO

SURVEYED BY: R.CARLSON

CLOSURE: _.00:10.000

MAP PAGE(S): 18-00-021-C

APPROVED BY: RRM DATE: 8-3-01 SCALE: 1"= 50' PRIOR INSTRUMENT; 20010727495