


PARENT PARCEL: 07-00-037-000-013,11-00-071-000-098

CHILD PARCEL:

STARTING POINT: INTERSECTION OF C/L OF DURKEE RD. AND C/L OF CHESTNUT RIDGE RD.

NO. 00578-A

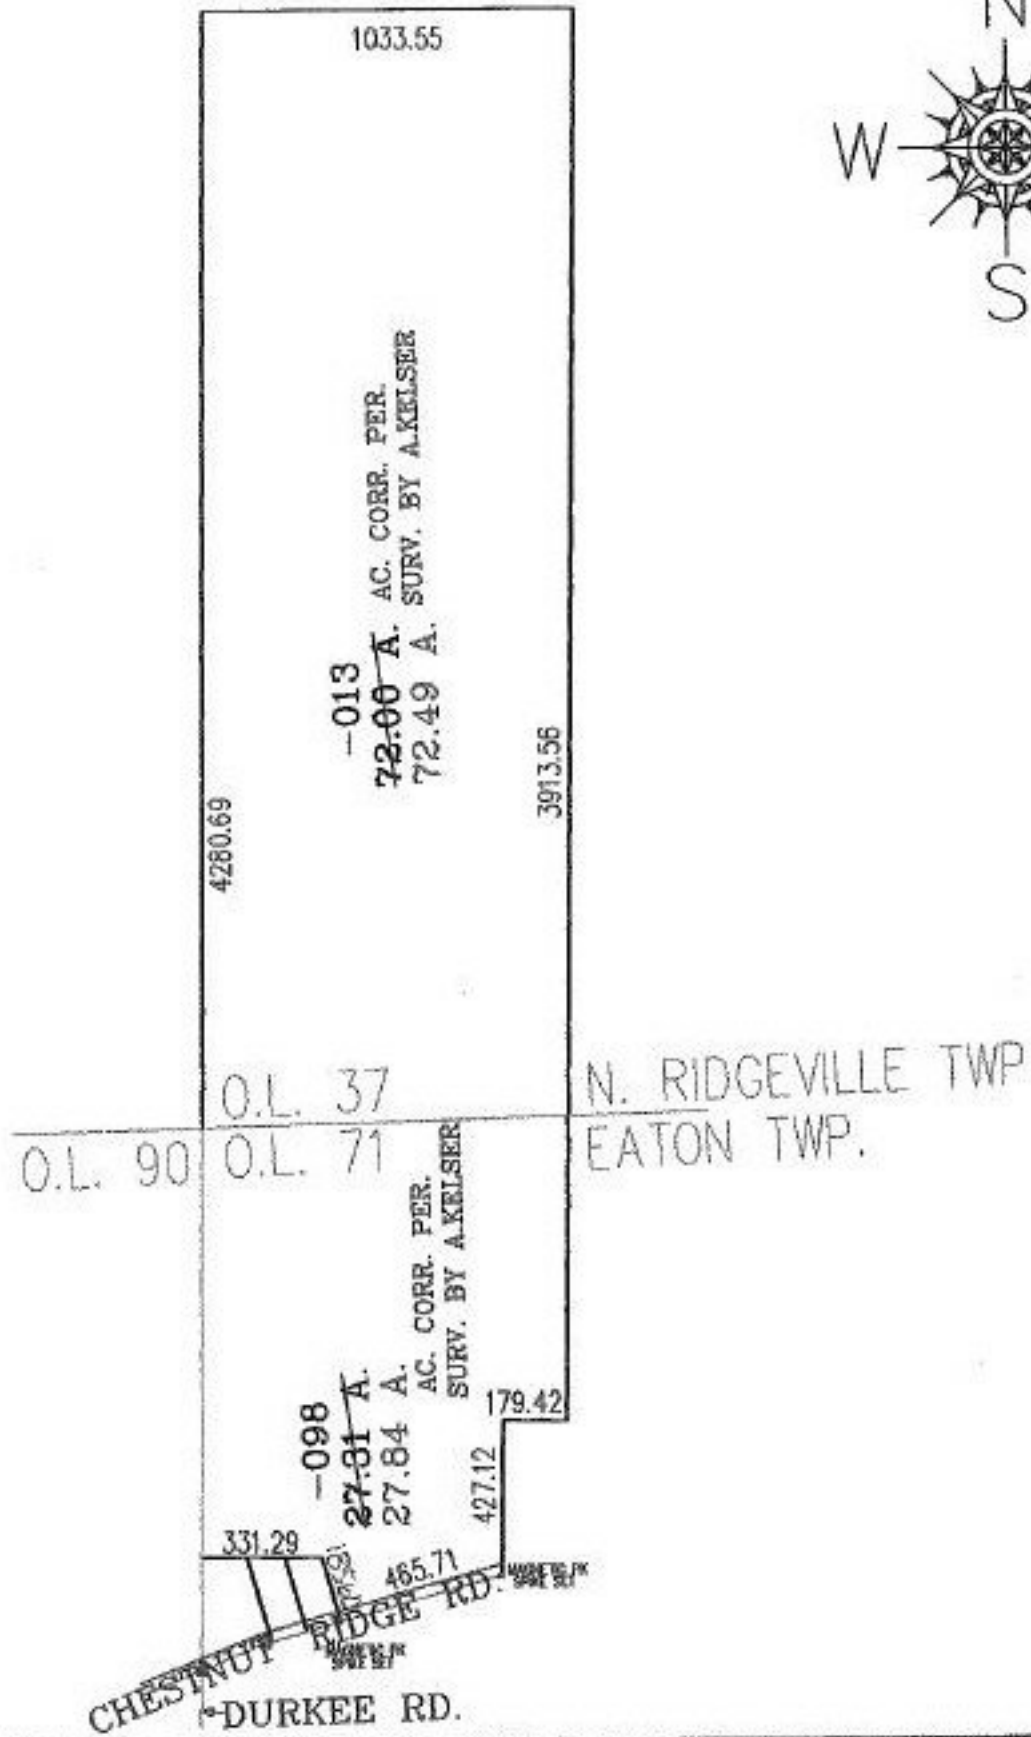

SPLITS/DEEDS PROCESSED

LORAIN COUNTY TAX MAP DEPARTMENT
226 MIDDLE AVE. ELYRIA, OHIO

SURVEYED BY: A.KELSER

CLOSURE: N/A

MAP PAGE(S): 7-E.11-00-071-A

APPROVED BY: RRM DATE: 8-9-01

SCALE: 1" = 600' PRIOR INSTRUMENT: OR 1362/964