

PASTER

PARENT PARCEL: 03-00-072-000-027.03-00-073-000-034.-037

CHILD PARCEL:

STARTING POINT: SOUTHWEST CORNER OF S/L 16 IN ACRE FARMS DIVISION


NO. 00603-0

# ACRE FARMS DIVISION

VOL. 10 PG. 16

WALNUT ST.

O.L. 71  
O.L. 72

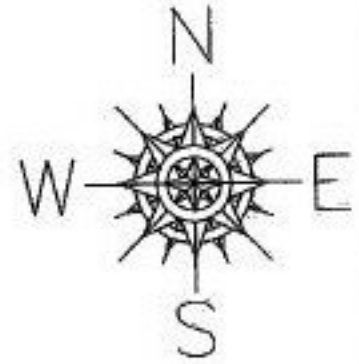


O.L. 72  
O.L. 73

O.L. 73  
O.L. 74

-006  
0.95 A.

DETROIT RD.

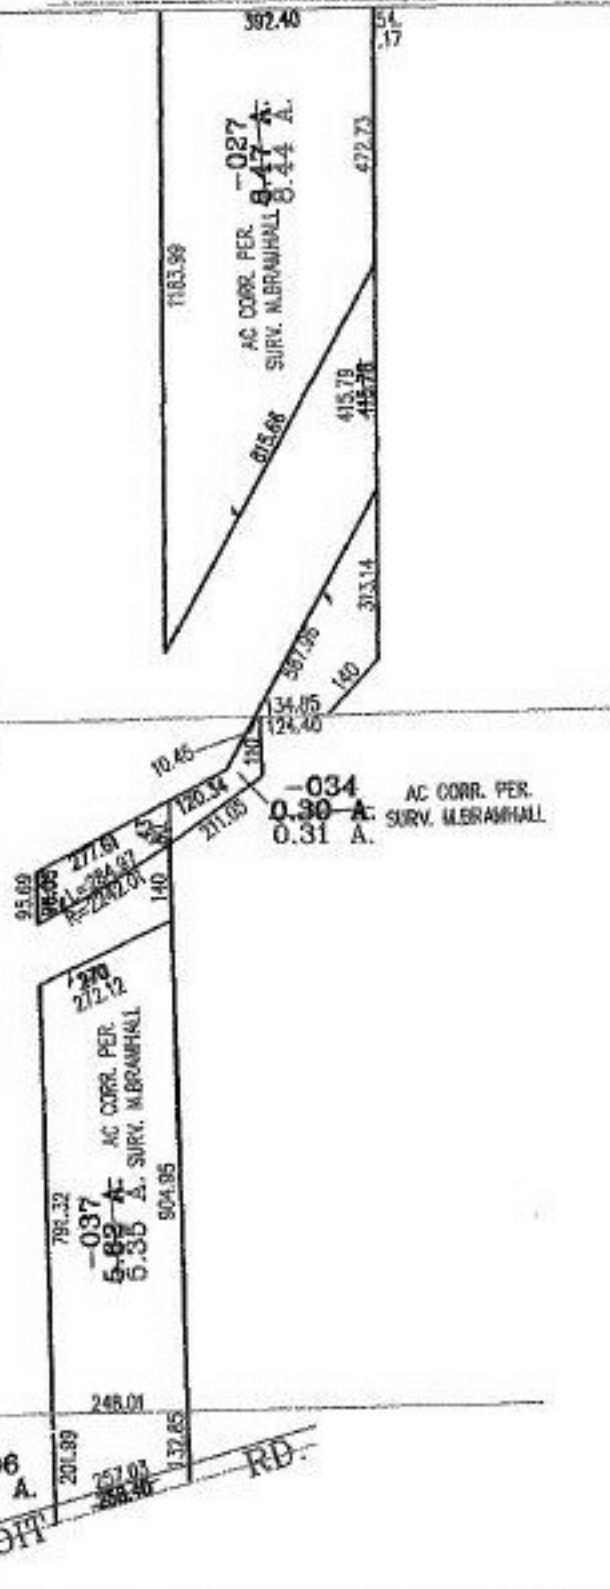

**SPLITS/DEEDS PROCESSED**  
LORAIN COUNTY TAX MAP DEPARTMENT  
226 MIDDLE AVE. ELYRIA, OHIO

SURVEYED BY: M. BRAMHALL  
CLOSURE: 01:10.000  
MAP PAGE(S): 3-00-071-B.3-00-073-B  
APPROVED BY: BRM DATE: 12-4-01  
SCALE: 1" = 400' PRIOR INSTRUMENT: DV 409/83