


MASTER

PARENT PARCEL: 09-00-067-000-032

NO. 00613-A

CHILD PARCEL:

STARTING POINT: INTERSECTION OF C/L OF BUTTERNUT RIDGE RD. AND WEST LINE OF O/L 67

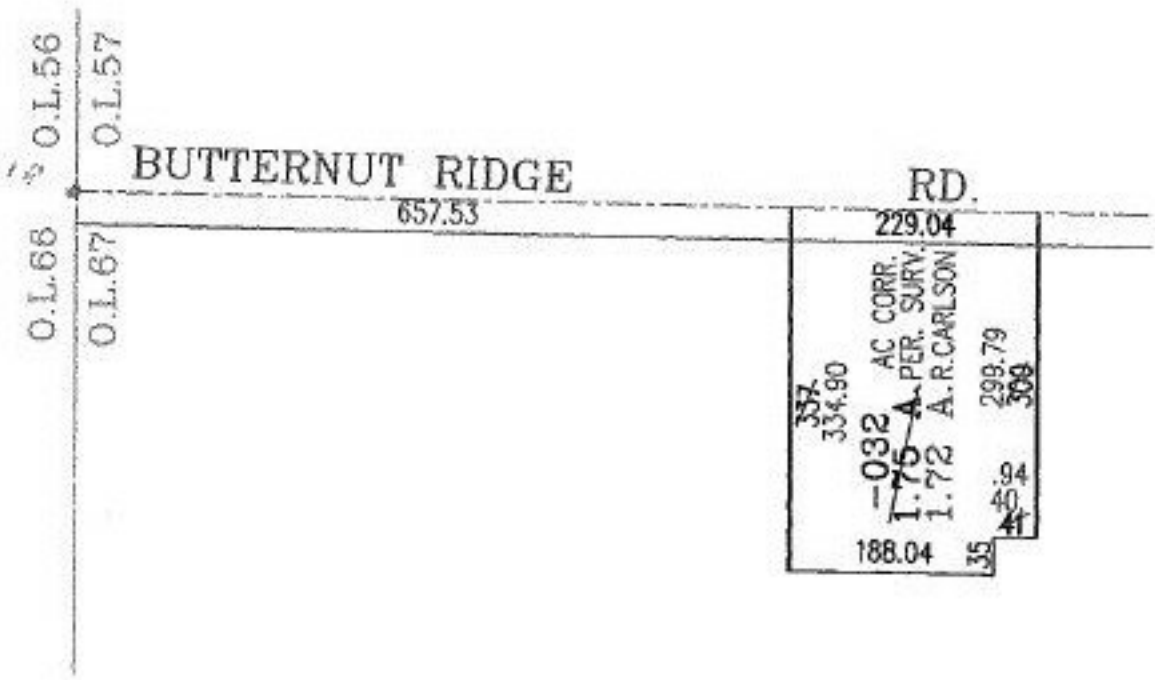

**SPLITS/DEEDS PROCESSED**  
 LORAIN COUNTY TAX MAP DEPARTMENT  
 226 MIDDLE AVE. ELYRIA, OHIO

SURVEYED BY: R. CARLSON  
 CLOSURE: N/A  
 MAP PAGE(S): 9-00-067-A  
 APPROVED BY: RBM DATE: 10-26-01  
 SCALE: 1" = 200' PRIOR INSTRUMENT: 20010743301