


PARENT PARCEL: 04-00-015-109-029

CHILD PARCEL:

STARTING POINT: INTERSECTION OF C/L OF WOOSTER AVON LAKE RD. AND C/L OF NORTH RIDGE RD.

NO. 00615-A

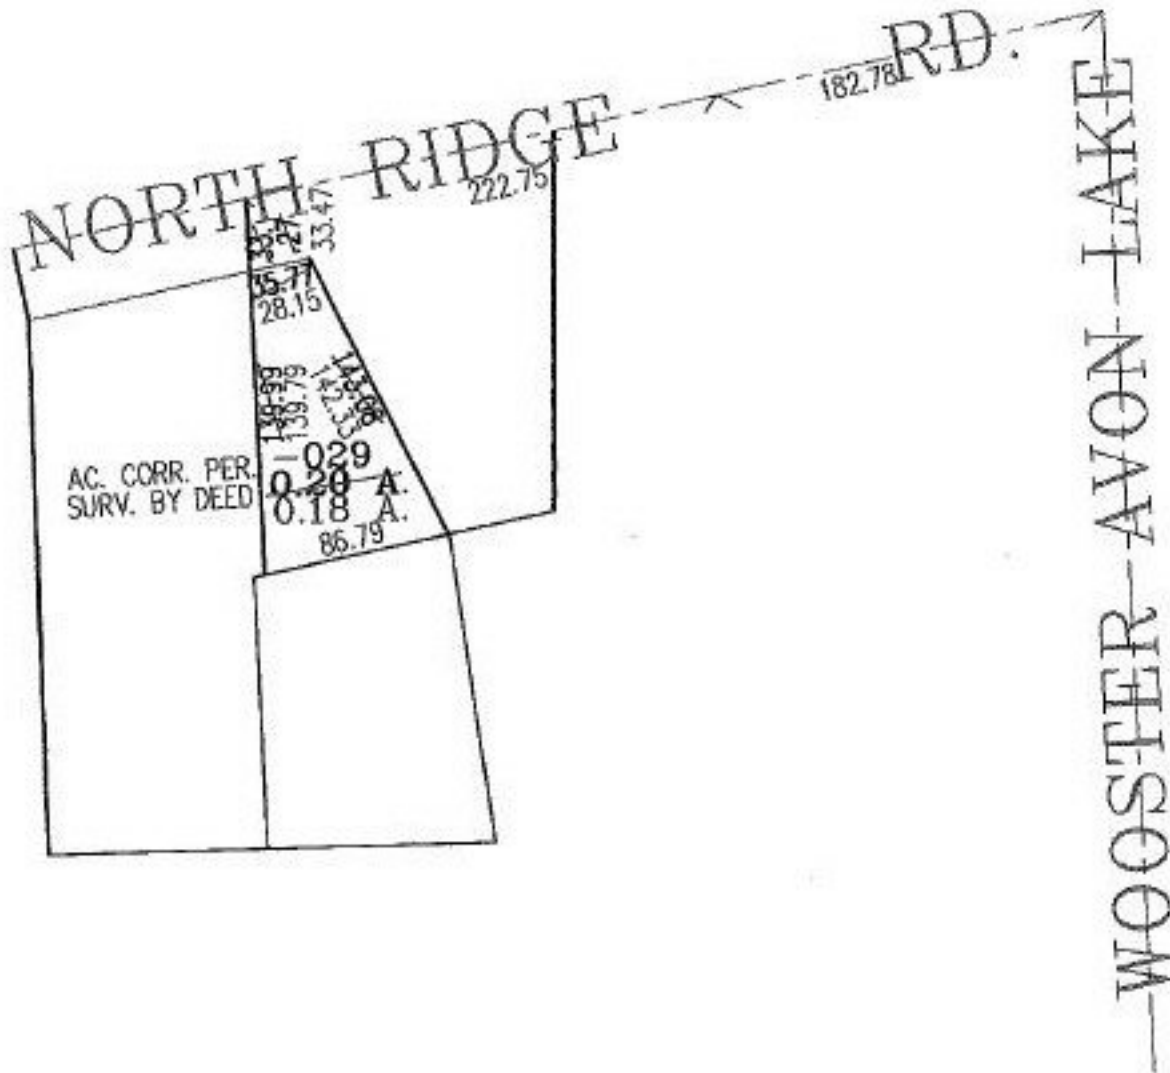

SPLITS/DEEDS PROCESSED
 LORAIN COUNTY TAX MAP DEPARTMENT
 226 MIDDLE AVE. ELYRIA, OHIO

SURVEYED BY: DEED
 CLOSURE: 00:10.000
 MAP PAGE(S): 4-00-015-B
 APPROVED BY: RRM DATE: 10-29-01
 SCALE: 1" = 100' PRIOR INSTRUMENT: DV 967/721