

RASTER

PARENT PARCEL: 07-00-014-103-249


CHILD PARCEL:

STARTING POINT: AT AN IRON PIPE AT THE NORTHEASTERLY CORNER OF DEERFIELD MEADOWS PH. NO. 1

NO. 00619-A



DEERFIELD MEADOWS PH. NO. 1
VOL. 64 PG. 30-31

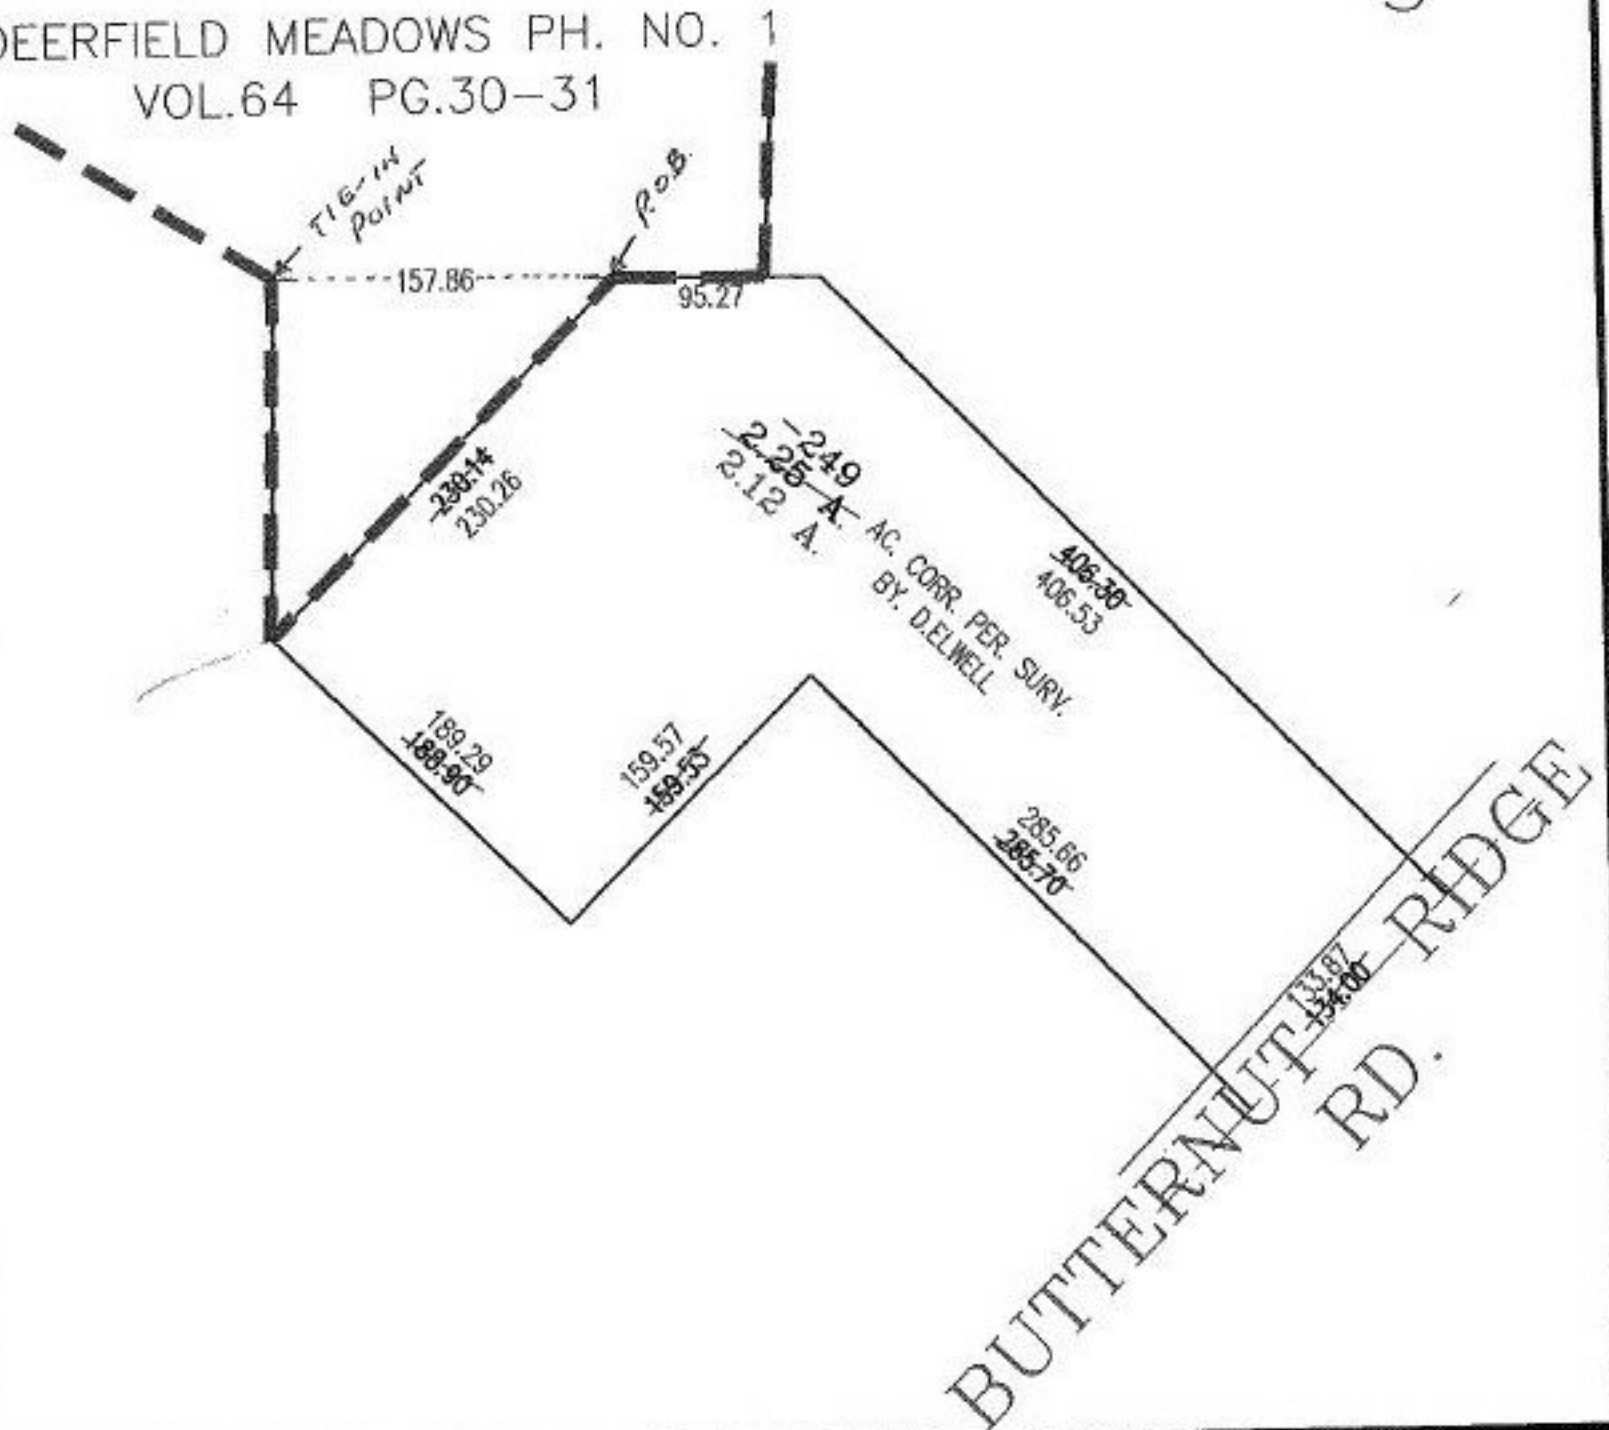

SPLITS/DEEDS PROCESSED

LORAIN COUNTY TAX MAP DEPARTMENT
226 MIDDLE AVE. ELYRIA, OHIO

SURVEYED BY: D. ELWELL
CLOSURE: 01:10.000
MAP PAGE(S): 7-00-014-B
APPROVED BY: RRM DATE: 12-13-01
SCALE: 1" = 100' PRIOR INSTRUMENT: OR 905/250