

PARENT PARCEL: 04-00-015-109-040



CHILD PARCEL:

STARTING POINT: AT A MON BOX AT THE INTERSECTION OF THE C/L OF SR 83 AND THE C/L OF DETROIT RD.

NO. 00627-X



DETROIT

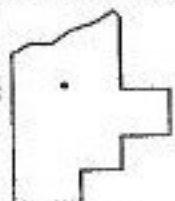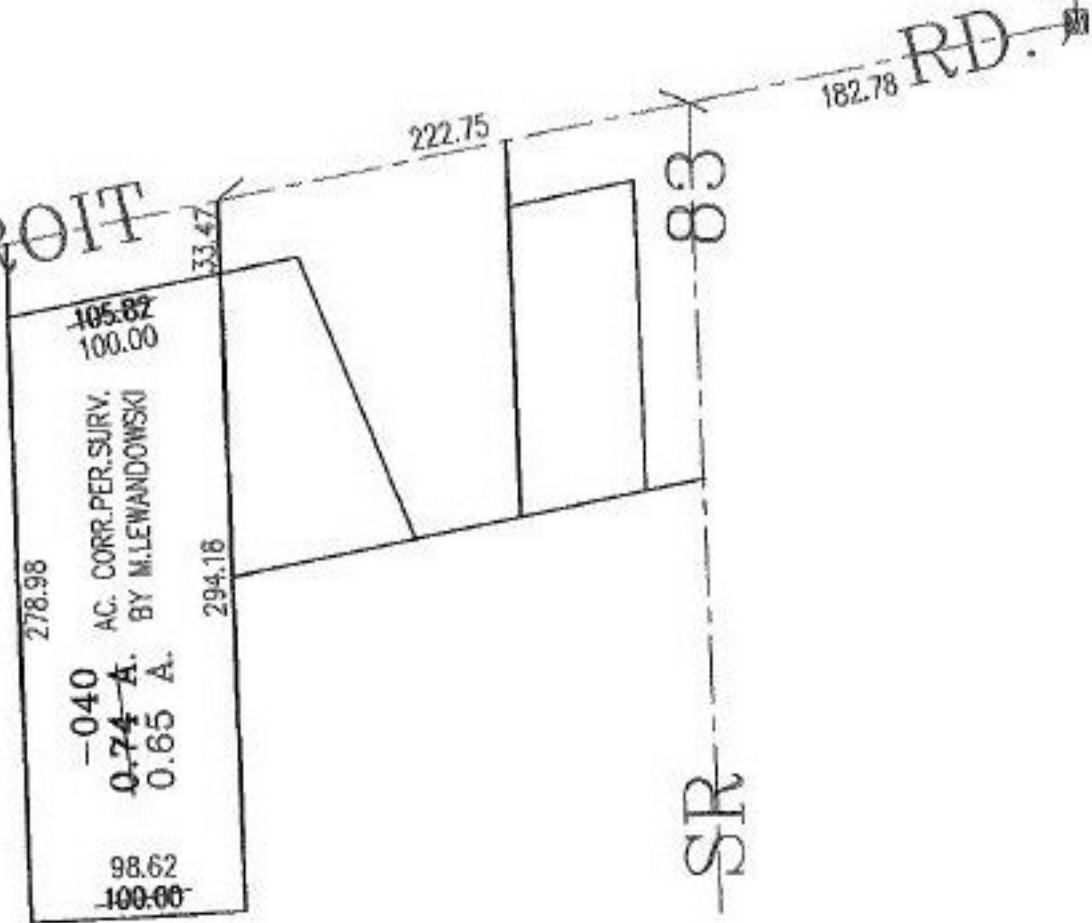

SPLITS/DEEDS PROCESSED

LORAIN COUNTY TAX MAP DEPARTMENT
226 MIDDLE AVE. ELYRIA, OHIO

SURVEYED BY: M. LEWANDOWSKI
 CLOSURE: N/A
 MAP PAGE(S): 4-00-015-B
 APPROVED BY: RRM DATE: 11-20-01
 SCALE: 1" = 100' PRIOR INSTRUMENT: OR 570/705