


PARENT PARCEL: 07-00-029-000-001, 07-00-032-000-014

CHILD PARCEL:

STARTING POINT: AT A MON BOX AT THE INTERSECTION OF C/L OF BARRES RD.
AND THE NORTHWEST CORNER OF O.L. 32

NO. 00632-A

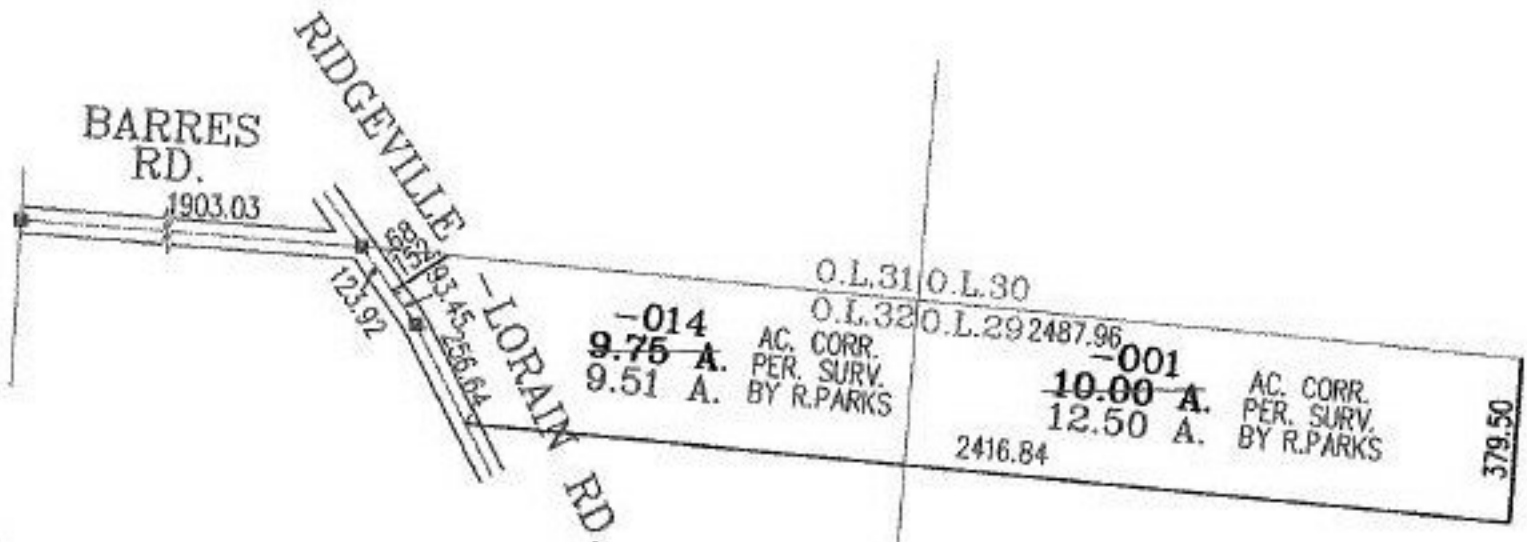

SPLITS/DEEDS PROCESSED

LORAIN COUNTY TAX MAP DEPARTMENT
226 MIDDLE AVE. ELYRIA, OHIO

SURVEYED BY: ROBERT S. PARKS

CLOSURE: 00:10.000

MAP PAGE(S): 7-B

APPROVED BY: RRM DATE: 1-15-02

SCALE: 1" = 500 PRIOR INSTRUMENT: DV 766/466