
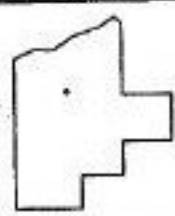


MASTER

NO. 00701

PARENT PARCEL: 01-00-039-000-009
CHILD PARCEL: 01-00-039-000-060, -061
STARTING POINT: CENTERLINE OF NORTH RIDGE RD. & O.L. 39

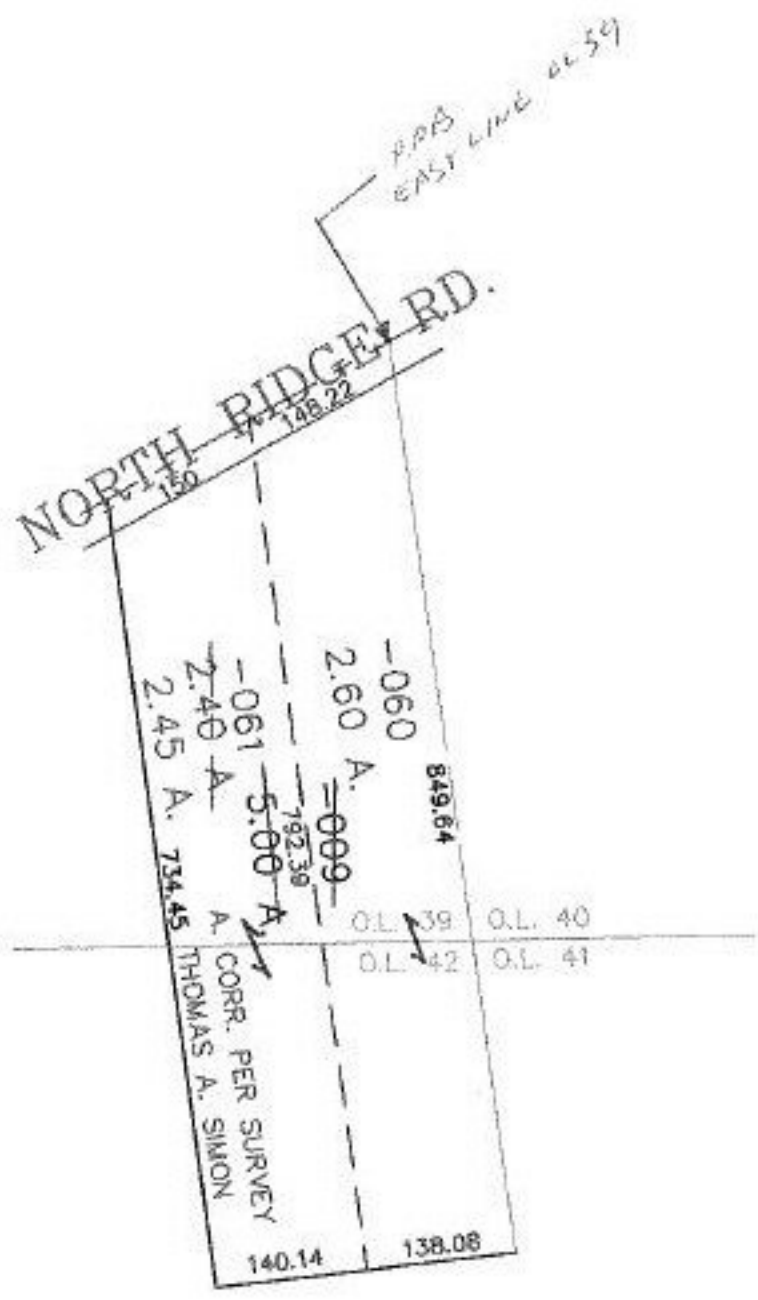

SPLITS/DEEDS PROCESSED
LORAIN COUNTY TAX MAP DEPARTMENT
226 MIDDLE AVE. ELYRIA, OHIO

SURVEYED BY: THOMAS A. SIMON
CLOSURE: 0.00 ; 10,000
MAP PAGE(S): 1-H
APPROVED BY: JAH DATE: 3-29-01
SCALE: 1" = 200' PRIOR INSTRUMENT: 20000716309