


FASER

PARENT PARCEL: 01-00-034-000-040
CHILD PARCEL: 01-00-034-000-052, -053
STARTING POINT: INTERSECTION OF COOPER FOSTER PARK RD. AND VERMILION RD.

NO. 00708

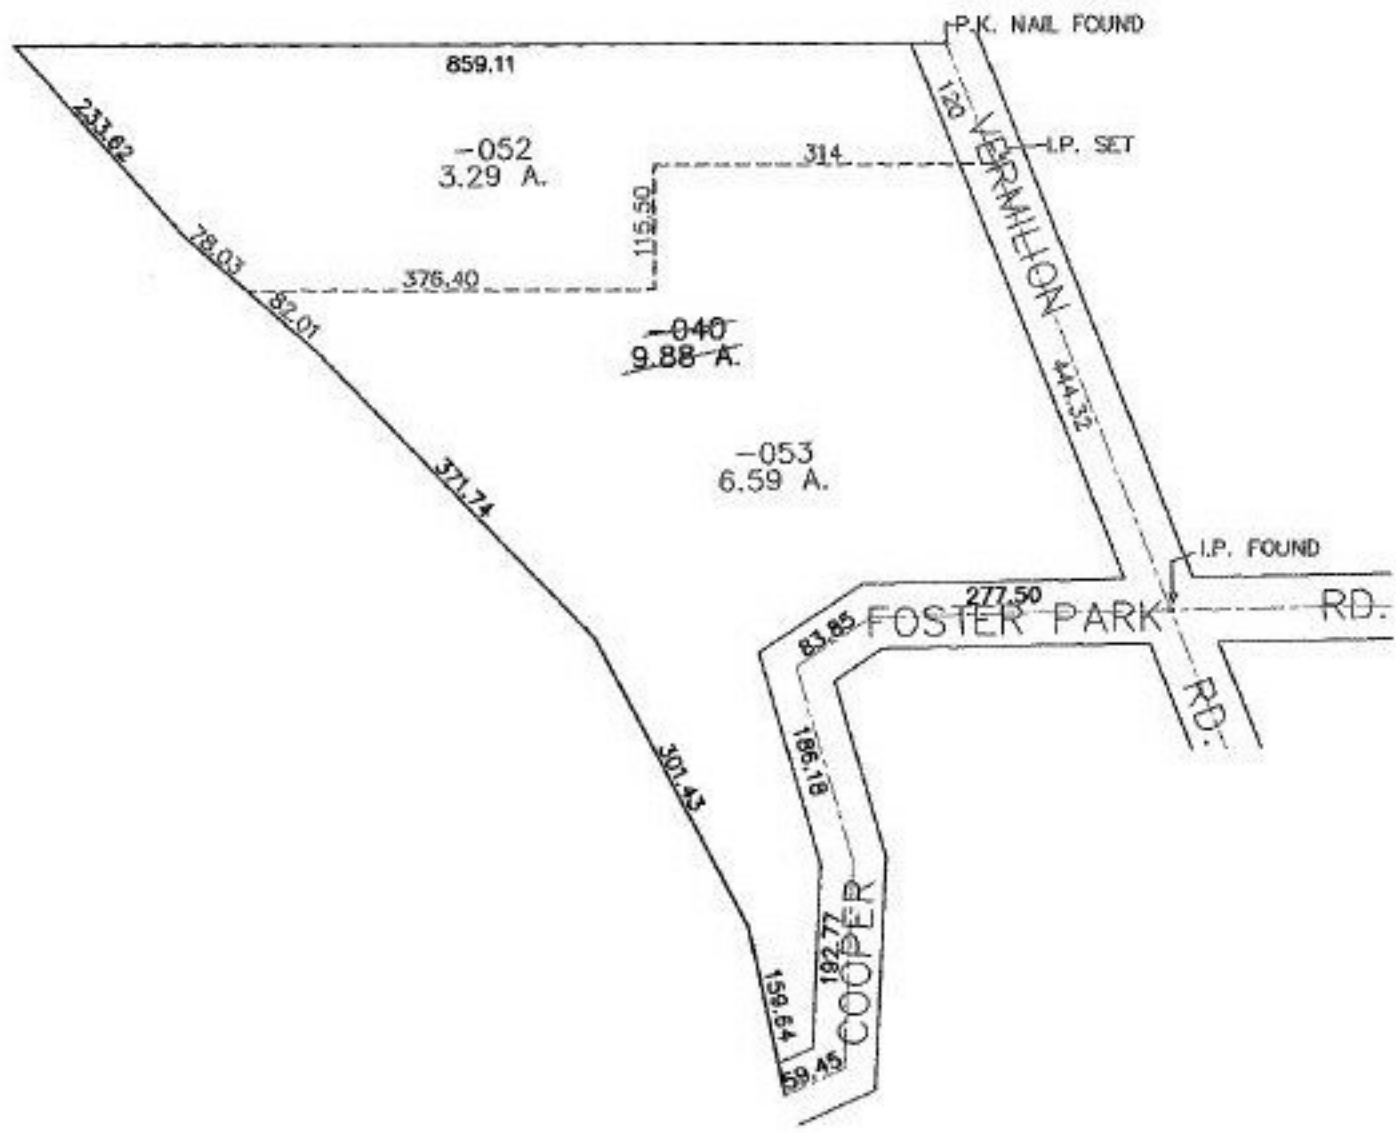

SPLITS/DEEDS PROCESSED
LORAIN COUNTY TAX MAP DEPARTMENT
226 MIDDLE AVE. ELYRIA, OHIO

SURVEYED BY: C.WARYU
CLOSURE: N/A
MAP PAGE(S): 1-E
APPROVED BY: BRM DATE: 4-3-01
SCALE: 1" = 200' PRIOR INSTRUMENT: OR 1176/785