

RASTER

PARENT PARCEL: 09-00-022-000-009

CHILD PARCEL: 09-00-022-000-010, -011

STARTING POINT: AT A MON. BOX AT THE INTERSECTION OF RUSSIA RD. AND QUARRY RD.

NO. 00709





RUSSIA RD.

RD.

2073.20

QUARRY RD.

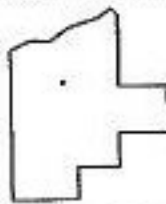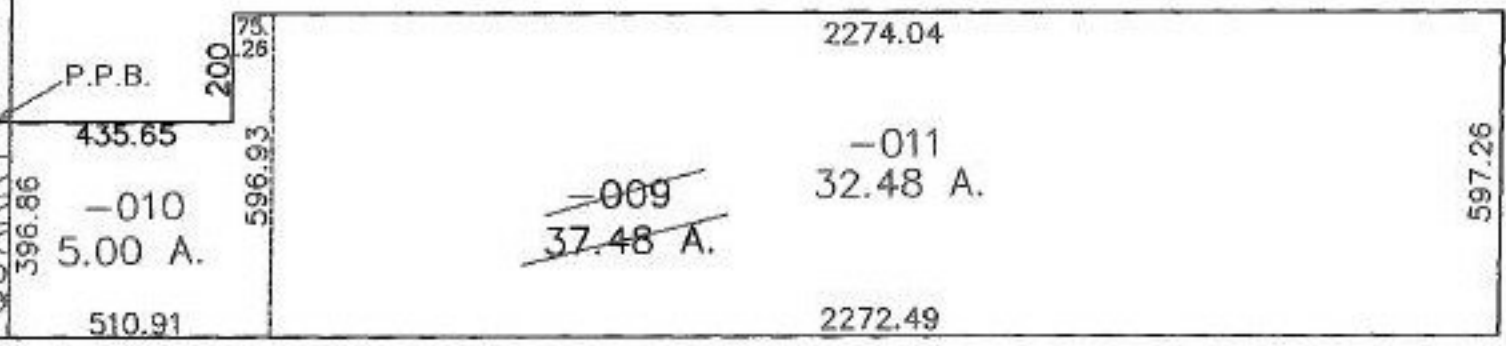

**SPLITS/DEEDS PROCESSED**  
 LORAIN COUNTY TAX MAP DEPARTMENT  
 226 MIDDLE AVE. ELYRIA, OHIO

SURVEYED BY: D. ELWELL  
 CLOSURE: N/A  
 MAP PAGE(S): 9-00-022-A&B  
 APPROVED BY: R.R.M. DATE: 4-2-01  
 SCALE: 1" = 400' PRIOR INSTRUMENT: OR 586/399