



EASTER

NO. 00712

PARENT PARCEL: 08-12-016-000-009

CHILD PARCEL: 08-12-016-000-021, -022

STARTING POINT: CENTERLINE OF VERMILION RD. & HENRIETTA TOWNSHIP LINE

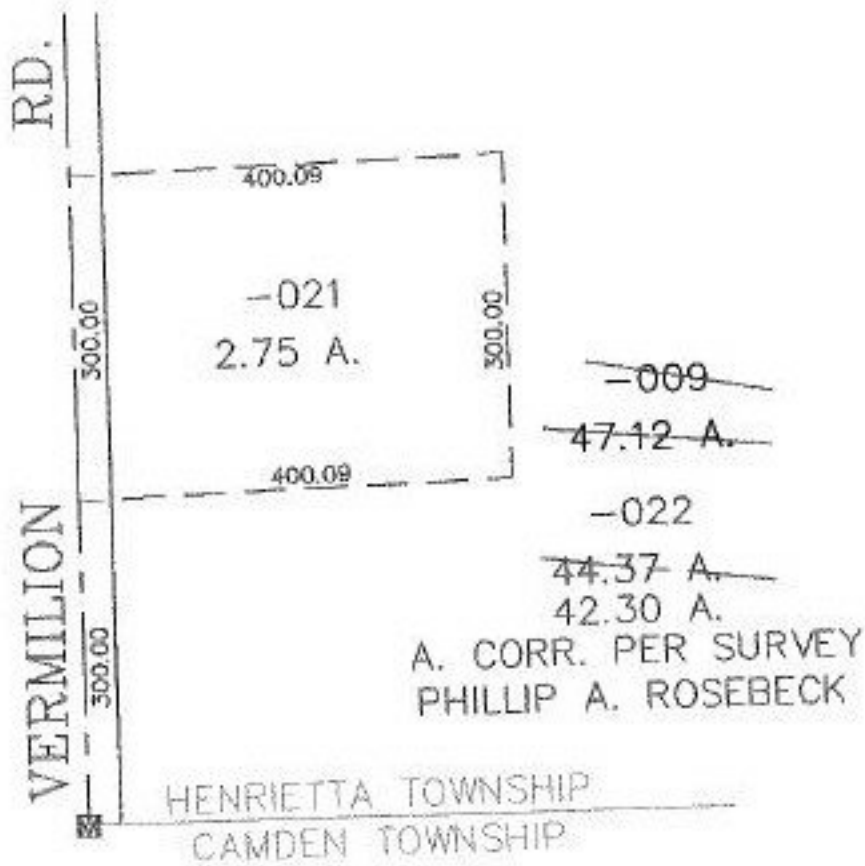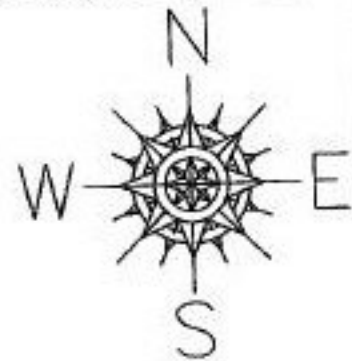

**SPLITS/DEEDS PROCESSED**

LORAIN COUNTY TAX MAP DEPARTMENT  
226 MIDDLE AVE. ELYRIA, OHIO

SURVEYED BY: PHILLIP A. ROSEBECK

CLOSURE: 0.00 : 10,000

MAP PAGE(S): 8-G

APPROVED BY: JAH DATE: 4-6-01

SCALE: 1" = 200' PRIOR INSTRUMENT: DV 1175/630