


PARENT PARCEL: 18-00-021-114-048
CHILD PARCEL: 18-00-021-114-086, -087
STARTING POINT: CENTERLINE OF HERRICK AVE. & O.L. 21

NO. 00714

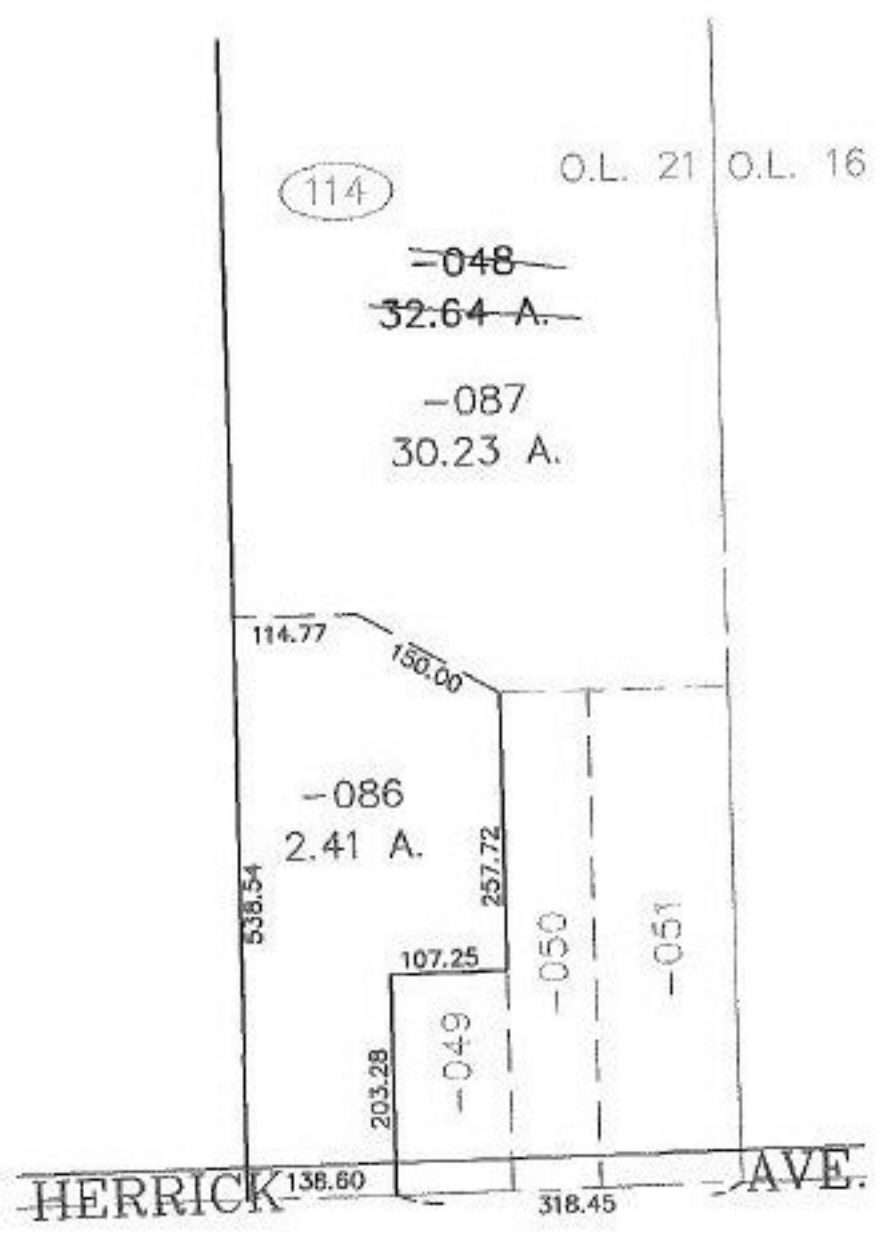

SPLITS/DEEDS PROCESSED
LORAIN COUNTY TAX MAP DEPARTMENT
226 MIDDLE AVE. ELYRIA, OHIO

SURVEYED BY: THOMAS M. SNEZEK
CLOSURE: 0.00 : 10.000
MAP PAGE(S): 18-00-021-A, D
APPROVED BY: JAH DATE: 4-9-01
SCALE: 1" = 200' PRIOR INSTRUMENT: 20000702061