


RASTER

PARENT PARCEL: 09-00-015-000-004

CHILD PARCEL: 09-00-015-000-039 & -040

STARTING POINT: CL OF S.R. 58 & CL OF RUSSIA RD.

NO. 00720

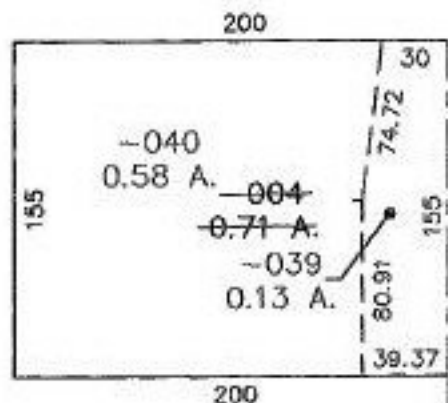

OBERLIN NORTH RD. (S.R. 58)

RUSSIA RD.

641.28



**SPLITS/DEEDS PROCESSED**

LORAIN COUNTY TAX MAP DEPARTMENT  
226 MIDDLE AVE. ELYRIA, OHIO

SURVEYED BY: JAMES E. KENYON

CLOSURE: 0.04 : 10,000

MAP PAGE(S): 9-B

APPROVED BY: TJS DATE: 04/24/01

SCALE: 1" = 100 PRIOR INSTRUMENT: DV 1425/158