

MASTER

PARENT PARCEL: 02-01-006-117-006, -007


CHILD PARCEL: 02-01-006-117-041 THRU -044

STARTING POINT: RIGHT OF WAY LINE OF OBERLIN AVE & WEST 11TH ST.

NO. 00728



OBERLIN AVE.

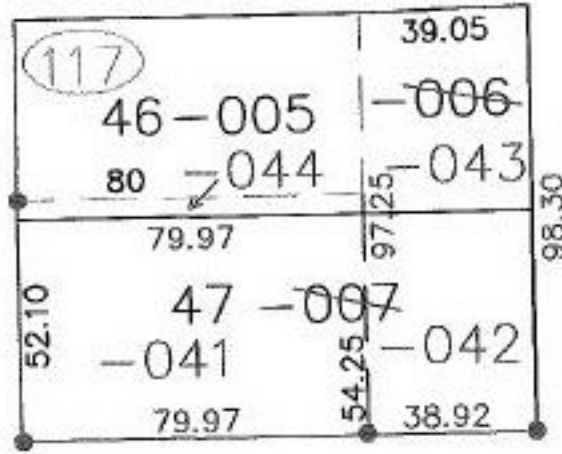

WEST 11TH ST.



SPLITS/DEEDS PROCESSED

LORAIN COUNTY TAX MAP DEPARTMENT
226 MIDDLE AVE. ELYRIA, OHIO

SURVEYED BY: PHILLIP A. ROSEBECK

CLOSURE: 0.00 : 10.000

MAP PAGE(S): 2-01-006-B

APPROVED BY: JAH DATE: 4-25-01

SCALE: 1" = 50' PRIOR INSTRUMENT: 990638914