


RASTER

PARENT PARCEL: 04-00-002-103-004

CHILD PARCEL: 04-00-002-103-057, -058

STARTING POINT: CENTERLINE OF MOON RD. & DETROIT RD.

NO. 00729

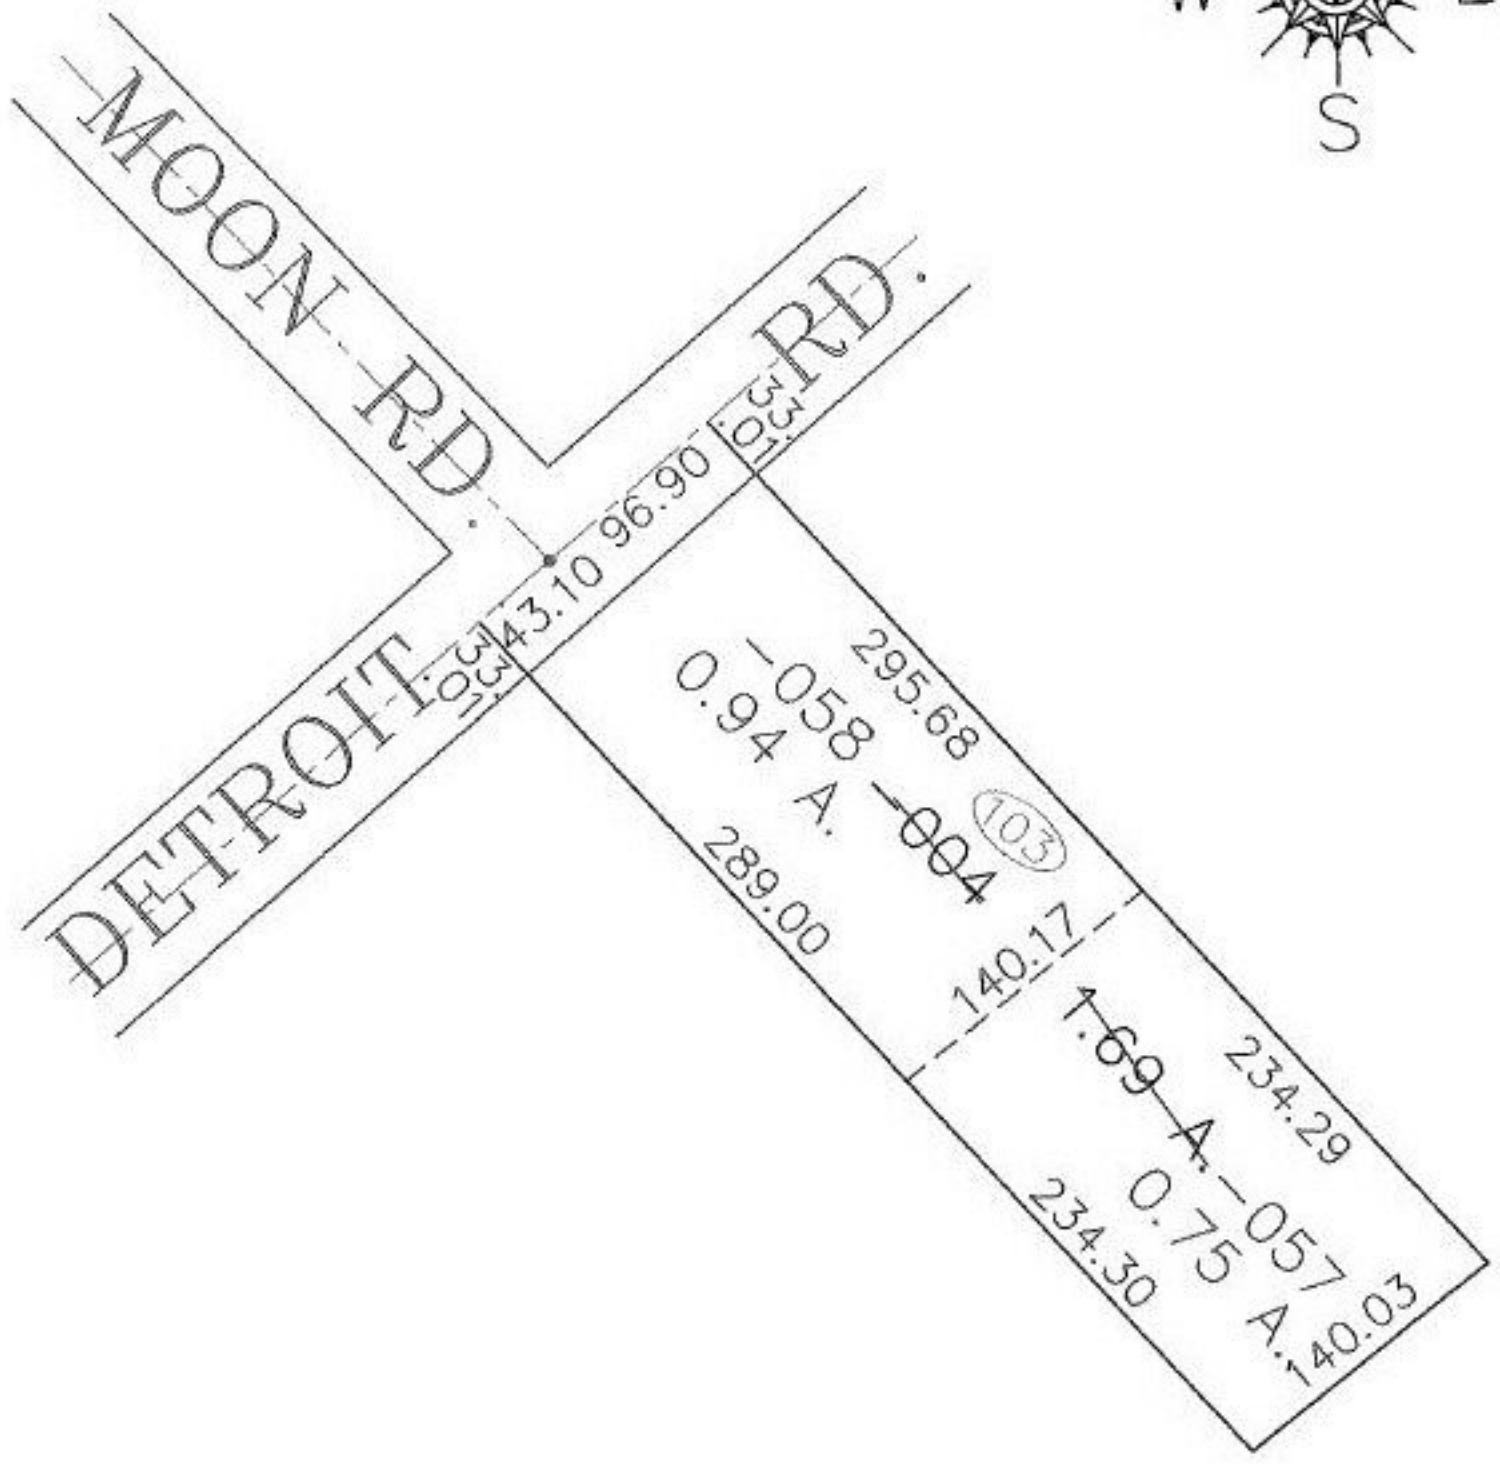

**SPLITS/DEEDS PROCESSED**

LORAIN COUNTY TAX MAP DEPARTMENT  
226 MIDDLE AVE. ELYRIA, OHIO

SURVEYED BY: JAMES A. RESAR

CLOSURE: 0.00 : 10.000

MAP PAGE(S): 04-00-002-G

APPROVED BY: JAH DATE: 05-09-01

SCALE: 1" = 100' PRIOR INSTRUMENT: OR 677/89