



RASTER

PARENT PARCEL: 01-00-055-000-002

CHILD PARCEL: 01-00-055-000-046 thru -049

STARTING POINT: CENTERLINE OF MIDDLE RIDGE RD. & BAUMHART RD.

NO. 00733

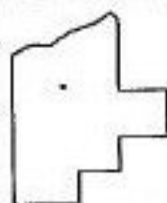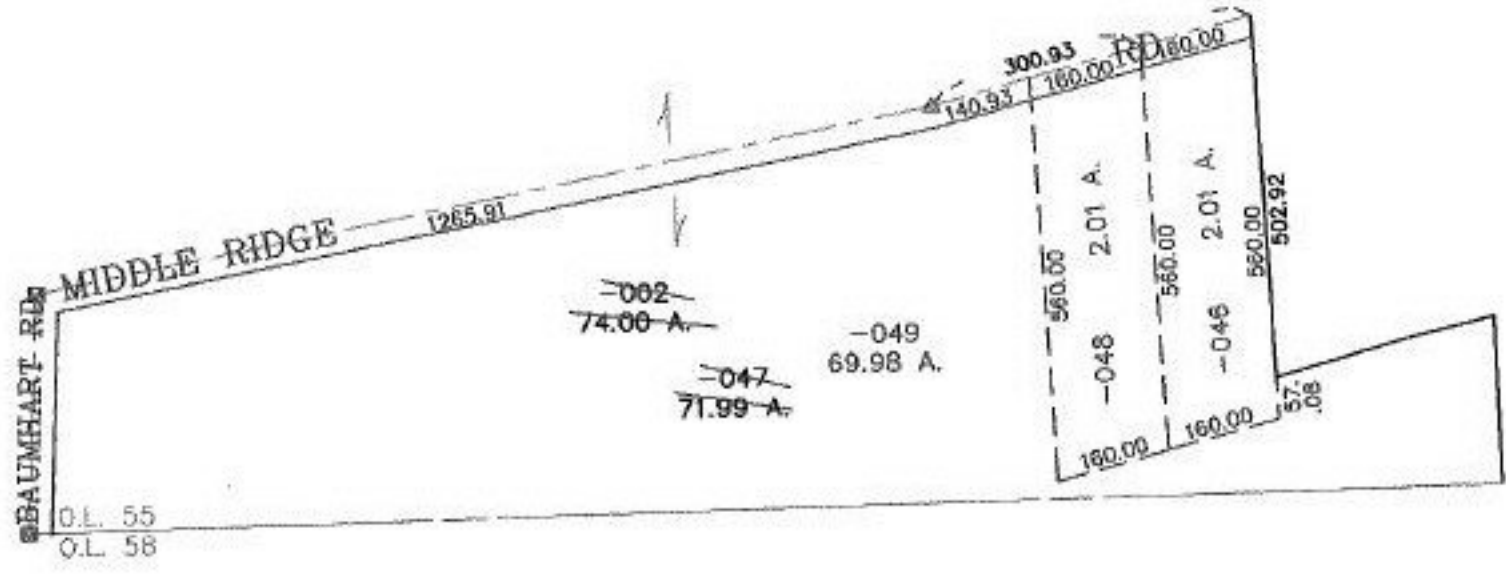

**SPLITS/DEEDS PROCESSED**

LORAIN COUNTY TAX MAP DEPARTMENT  
226 MIDDLE AVE. ELYRIA, OHIO

SURVEYED BY: THOMAS A. SIMON  
 CLOSURE: 0.00 : 10.000  
 MAP PAGE(S): 1-L  
 APPROVED BY: JAH DATE: 4-27-01  
 SCALE: 1" = 300' PRIOR INSTRUMENT: 20010736366