


EASTER

NO. 00734

PARENT PARCEL: 04-00-013-000-115, -116
CHILD PARCEL: 04-00-013-000-396 thru -398
STARTING POINT: CENTERLINE OF WOOSTER-AVON LAKE RD. & SOUTH PARK DR.

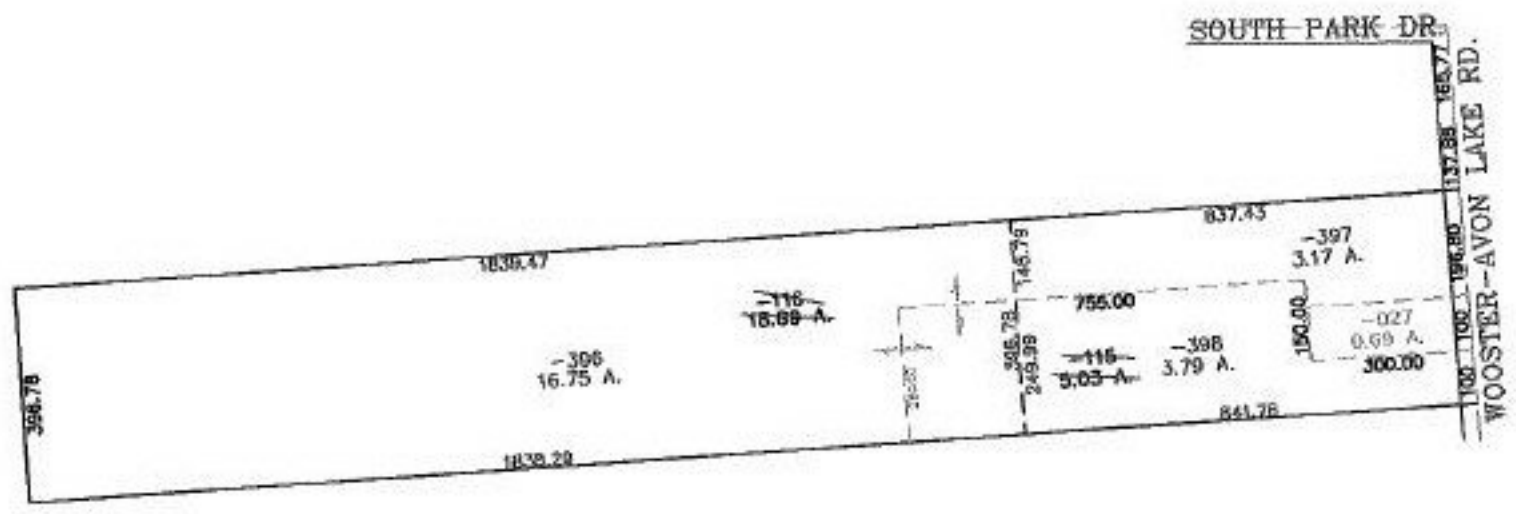

SPLITS/DEEDS PROCESSED
LORAIN COUNTY TAX MAP DEPARTMENT
226 MIDDLE AVE. ELYRIA, OHIO

SURVEYED BY: RICHARD A. THOMPSON JR.
CLOSURE: 0.00 : 10.000
MAP PAGE(S): 4-00-013-A, B
APPROVED BY: JAH DATE: 4-27-01
SCALE: 1" = 400' PRIOR INSTRUMENT: DV 1348/925