


MASTER

PARENT PARCEL: 04-00-019-119-011, -012, -013

CHILD PARCEL: 04-00-019-119-047, -048

STARTING POINT: SIDELINE OF FAY AVE & MIDWAY RD.

NO. 00739

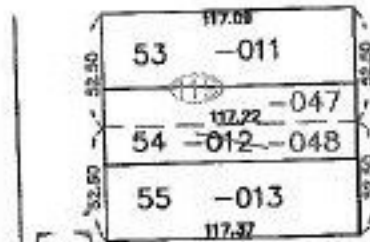

FAY AVE

FAY

MIDWAY RD.

SPLITS/DEEDS PROCESSED

LORAIN COUNTY TAX MAP DEPARTMENT
226 MIDDLE AVE. ELYRIA, OHIO

SURVEYED BY: CARL ANDERSON

CLOSURE: 0.10 : 10.000

MAP PAGE(S): 04-00-019-A

APPROVED BY: JAH DATE: 5-9-01

SCALE: 1" = 100' PRIOR INSTRUMENT: 710586