


RASTER

PARENT PARCEL: 05-00-055-000-032

CHILD PARCEL: 05-00-055-000-033, -034

STARTING POINT: CENTERLINE OF OBERLIN RD. & ACCESS STRIP FOR OHIO TURNPIKE

NO. 00741

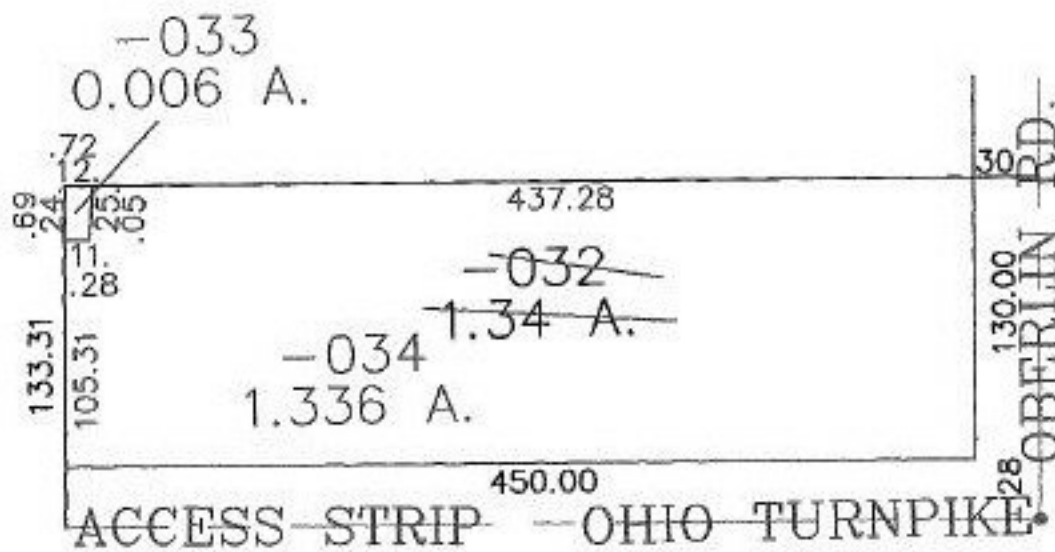

SPLITS/DEEDS PROCESSED

LORAIN COUNTY TAX MAP DEPARTMENT
226 MIDDLE AVE. ELYRIA, OHIO

SURVEYED BY: WILLIAM J. VONDRA

CLOSURE: 0.02 : 10.000

MAP PAGE(S): 5-G

APPROVED BY: JAH DATE: 6-11-01

SCALE: 1" = 100' PRIOR INSTRUMENT: 0006993756