


RASTER

PARENT PARCEL: 09-00-016-000-003  
CHILD PARCEL: 09-00-016-000-005, -006  
STARTING POINT: CENTERLINE OF RUSSIA RD. & OBERLIN RD.

NO. 00744

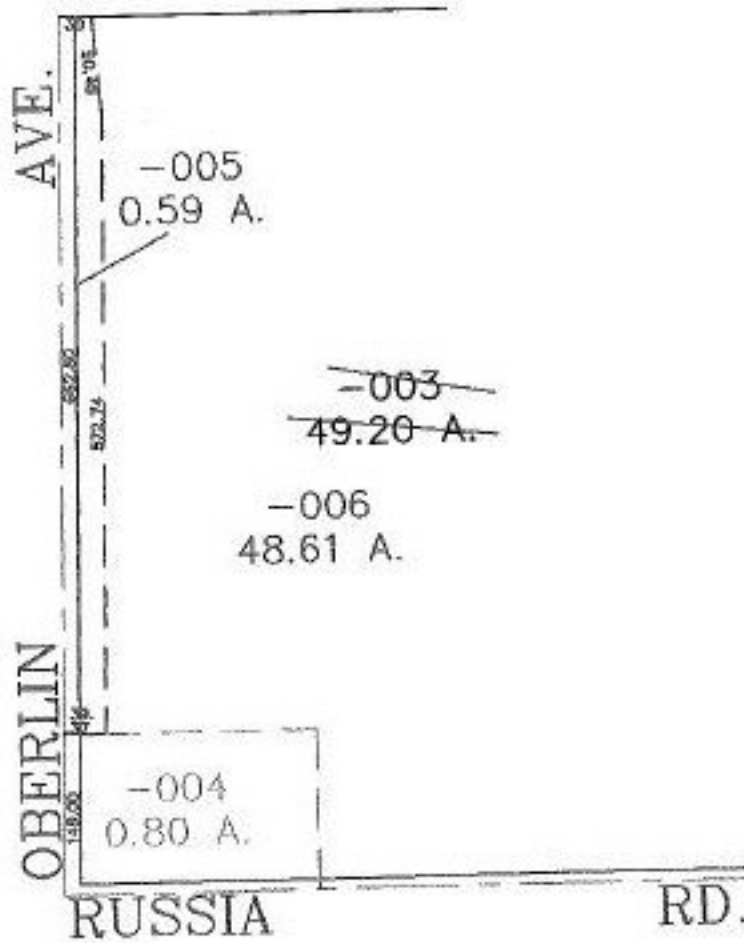

**SPLITS/DEEDS PROCESSED**  
LORAIN COUNTY TAX MAP DEPARTMENT  
226 MIDDLE AVE. ELYRIA, OHIO

SURVEYED BY: JAMES E. KENYON  
CLOSURE: 0.01 : 10,000  
MAP PAGE(S): 9-C  
APPROVED BY: JAH DATE: 5-14-01  
SCALE: 1" = 200' PRIOR INSTRUMENT: 970489207