


MASTER

PARENT PARCEL: 09-00-015-000-034

CHILD PARCEL: 09-00-015-000-041, -042

STARTING POINT: CENTER LINE OF RUSSIA RD. & OBERLIN RD.

NO. 00745

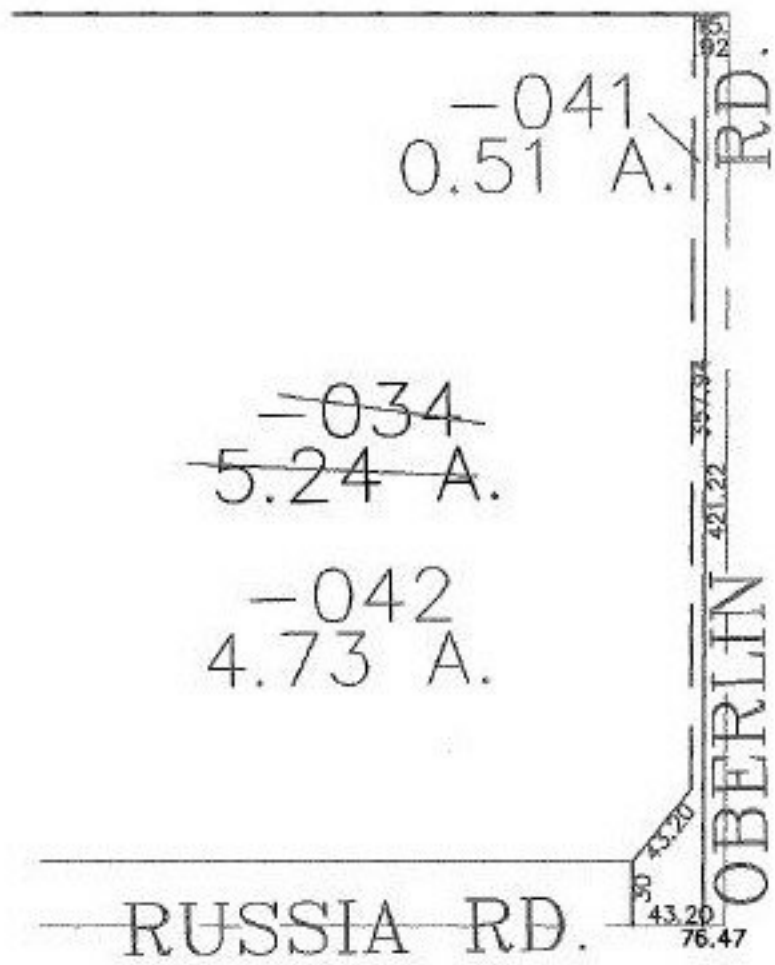

**SPLITS/DEEDS PROCESSED**  
 LORAIN COUNTY TAX MAP DEPARTMENT  
 226 MIDDLE AVE. ELYRIA, OHIO

SURVEYED BY: JAMES E. KENYON  
 CLOSURE: 0.01 : 10.000  
 MAP PAGE(S): 9-B  
 APPROVED BY: JAH DATE: 5-14-01  
 SCALE: 1" = 100' PRIOR INSTRUMENT: 980526654