

MASTER

PARENT PARCEL: ADD TO DUPLICATE
CHILD PARCEL: 17-20-017-000-040 & -041
STARTING POINT: CL OF S.R. 18 & WEST LINE OF O.L. 17


NO. 00750

ADD TO DUPLICATE

17-20-017-000-040
0.01 A.

COMBINATION

~~17-20-017-000-029~~
~~2.10 A.~~
17-20-017-000-040
~~0.01 A.~~
17-20-017-000-041
2.11 A.

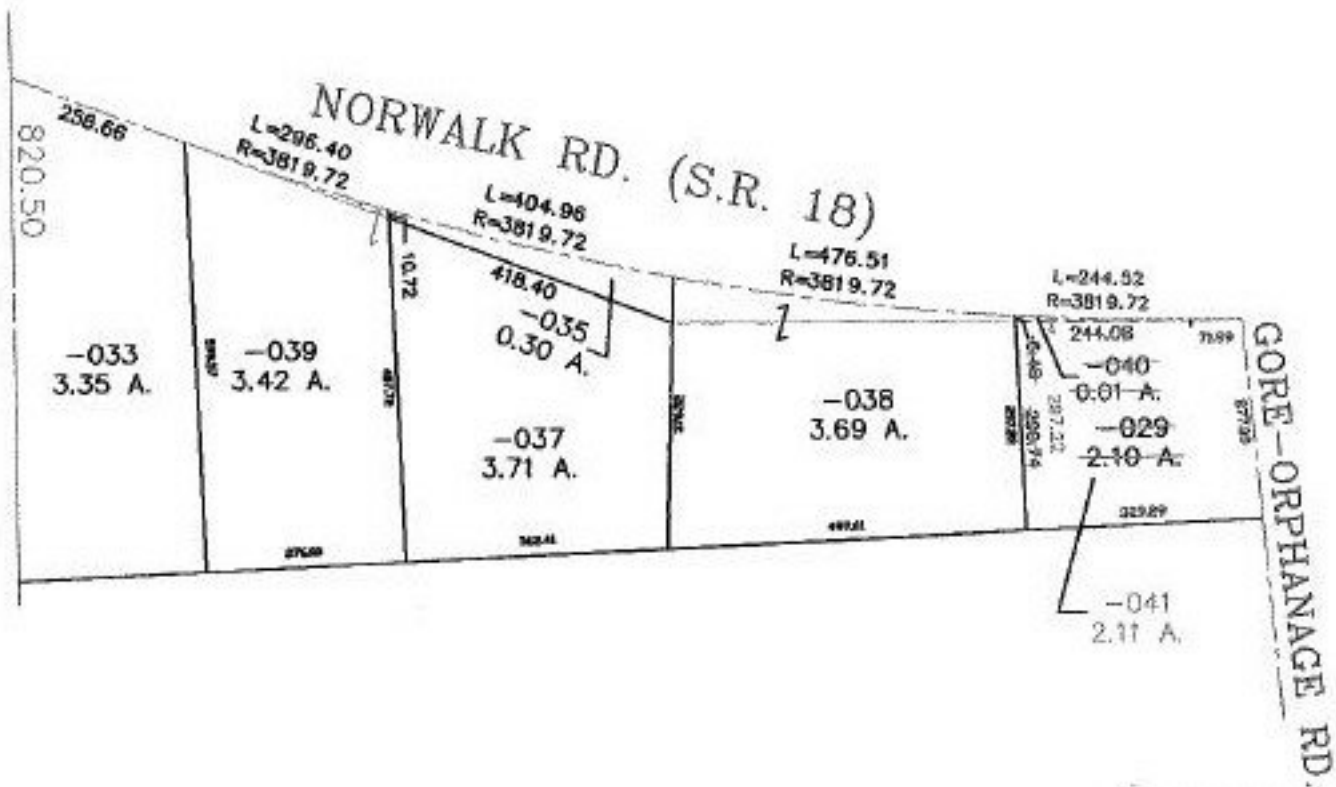

PRIOR INSTRUMENT: 980556039
PRIOR INSTRUMENT: 20010739406
PRIOR INSTRUMENT: 980556037
PRIOR INSTRUMENT: 20010739408

SURVEYED BY: THOMAS M. SNEZEK
CLOSURE: 0.01 : 10.000
MAP PAGE(S): 17-E
APPROVED BY: TJS DATE: 03/28/02
SCALE: 1" = 300



SPLITS/DEEDS PROCESSED
LORAIN COUNTY TAX MAP DEPARTMENT
226 MIDDLE AVE. ELYRIA, OHIO