


RASTER

PARENT PARCEL: 01-00-027-000-057

CHILD PARCEL: 01-00-027-000-074, -075

STARTING POINT: CENTERLINE OF COOPER FOSTER PK. RD. & BAUMHART RD.

NO. 00753

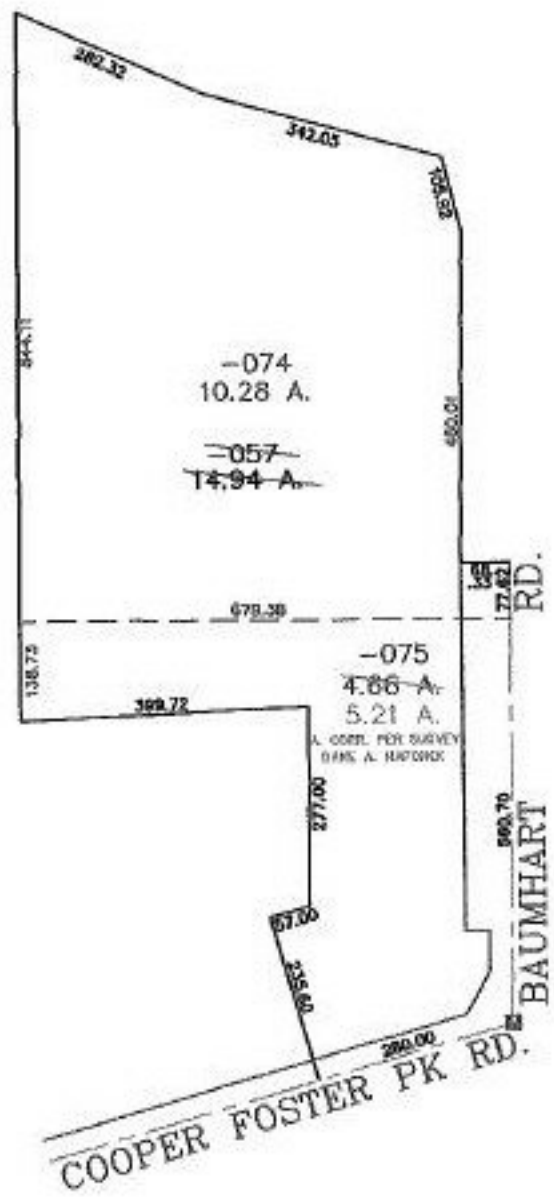

**SPLITS/DEEDS PROCESSED**  
LORAIN COUNTY TAX MAP DEPARTMENT  
226 MIDDLE AVE. ELYRIA, OHIO

SURVEYED BY: DANE A. HAPONEK  
CLOSURE: 0.00 : 10.000  
MAP PAGE(S): 1-00-027-B  
APPROVED BY: JAH DATE: 5-21-01  
SCALE: 1" = 300 PRIOR INSTRUMENT: DV 1420/57