
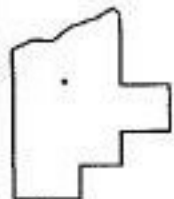


PARENT PARCEL: 04-00-012-103-060, -071
CHILD PARCEL: 04-00-012-103-217 THRU -220
STARTING POINT: CENTERLINE OF MILLS RD. & ST. RT. 83

NO. 00758

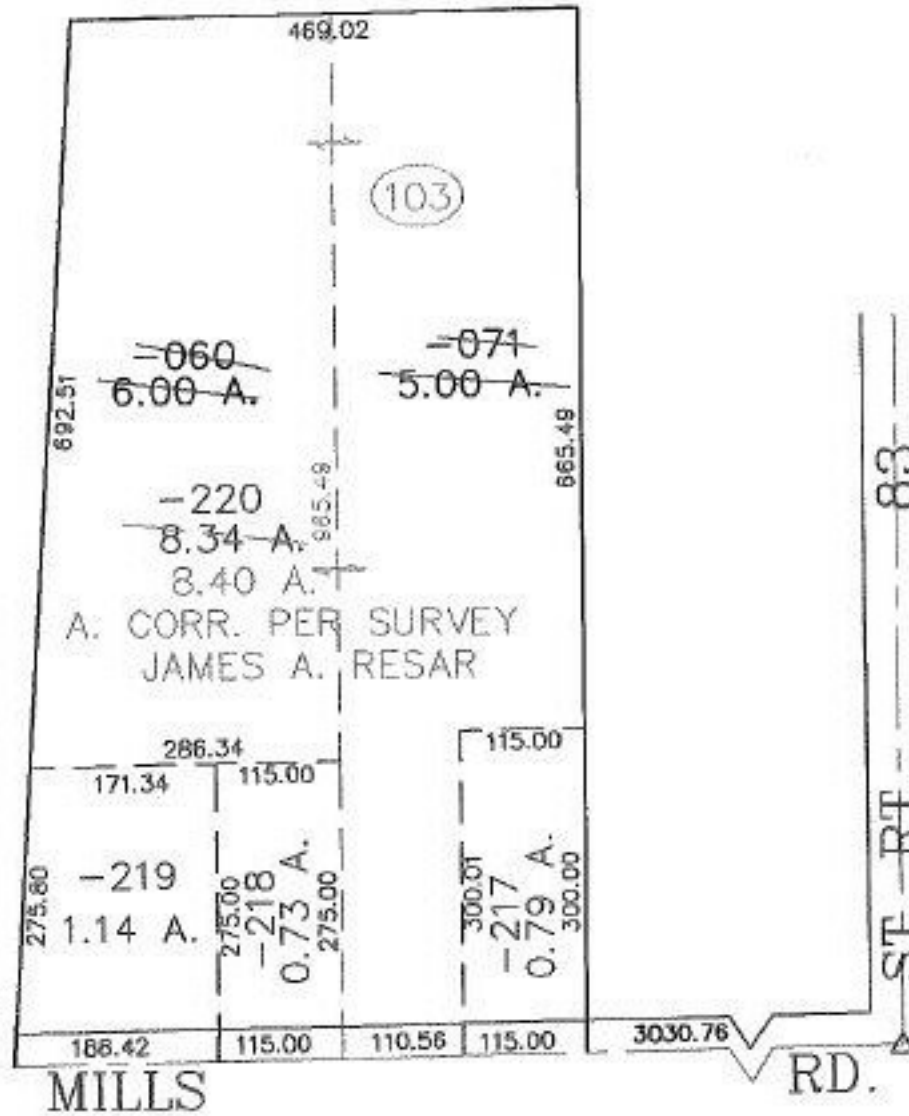

SPLITS/DEEDS PROCESSED
LORAIN COUNTY TAX MAP DEPARTMENT
226 MIDDLE AVE. ELYRIA, OHIO

SURVEYED BY: JAMES A. RESAR
CLOSURE: 0.00 : 10.00
MAP PAGE(S): 04-00-012-H
APPROVED BY: JAH DATE: 6-15-01
SCALE: 1" = 200' PRIOR INSTRUMENT: DV 1408/423