



RASTER

PARENT PARCEL: 10-00-012-000-043

CHILD PARCEL: 10-00-012-000-166, -167

STARTING POINT: CENTERLINE OF OBERLIN-ELYRIA RD. & BUTTERNUT RIDGE RD.

NO. 00761

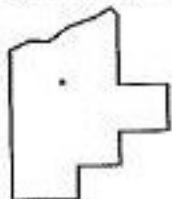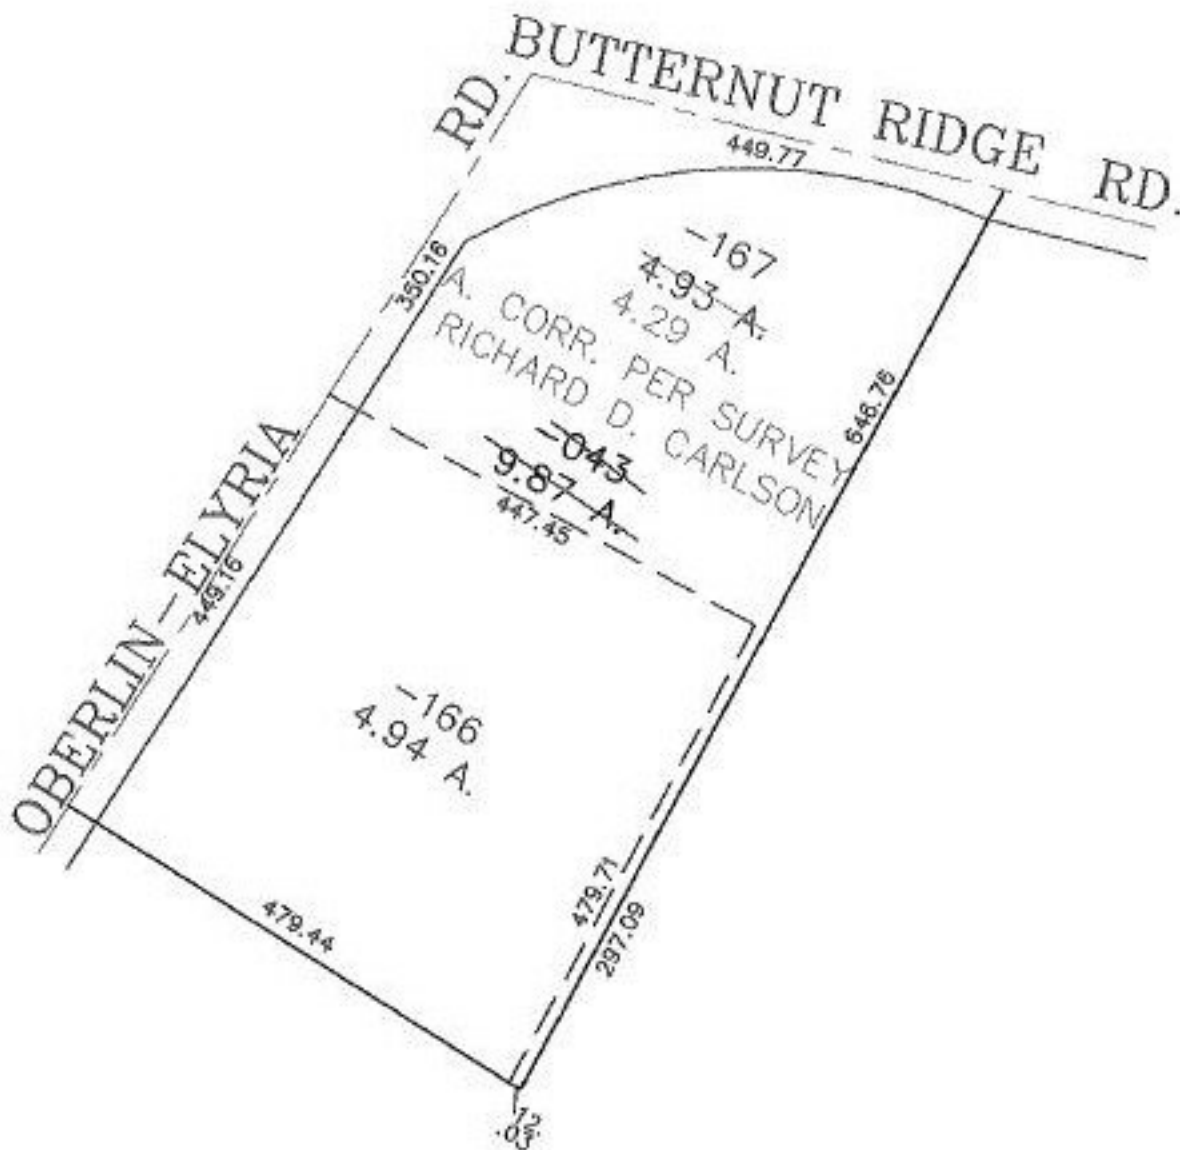

**SPLITS/DEEDS PROCESSED**  
**LORAIN COUNTY TAX MAP DEPARTMENT**  
**226 MIDDLE AVE. ELYRIA, OHIO**

SURVEYED BY: RICHARD D. CARLSON

CLOSURE: 0.01 : 10.000

MAP PAGE(S): 10-00-012-E

APPROVED BY: JAH DATE: 6-20-01

SCALE: 1" = 200 PRIOR INSTRUMENT: 990596484