



PASTER

PARENT PARCEL: 04-00-020-104-558  
CHILD PARCEL: 04-00-020-104-622 THRU -0624  
STARTING POINT: CENTERLINE OF LEAR RD. & DEERFIELD DR.

NO. 00786

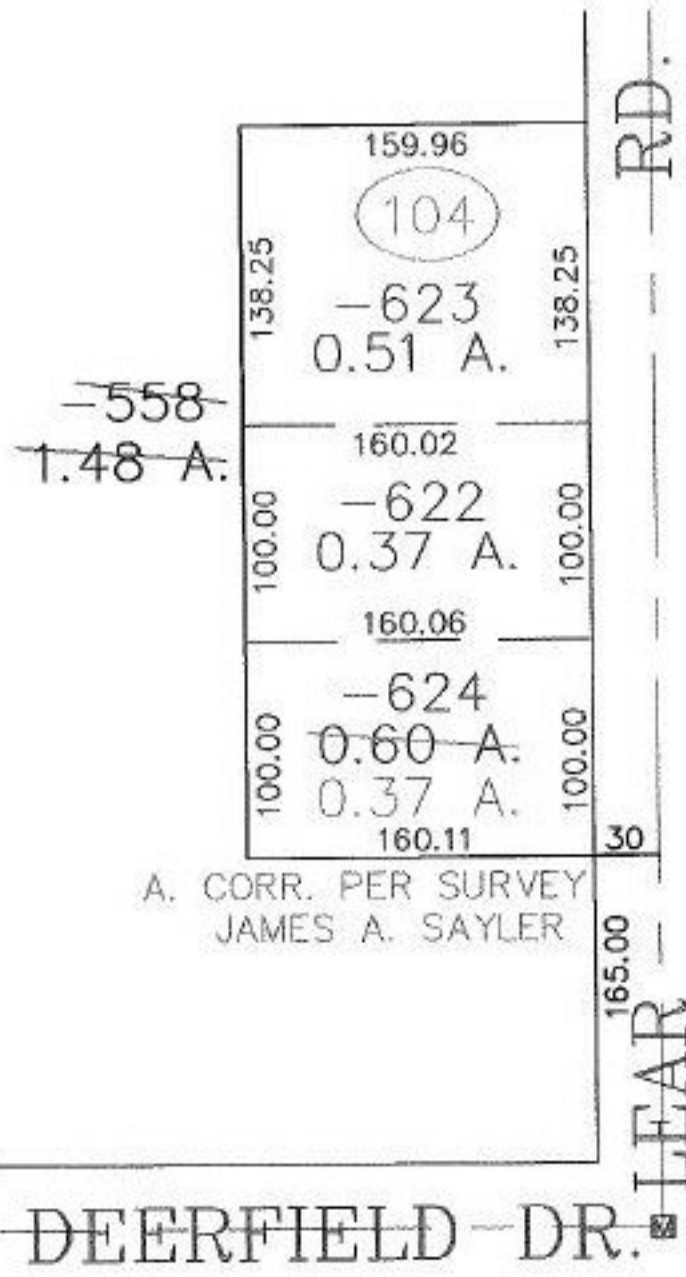

A. CORR. PER SURVEY  
JAMES A. SAYLER

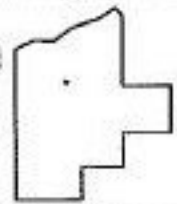

SPLITS/DEEDS PROCESSED

LORAIN COUNTY TAX MAP DEPARTMENT  
228 MIDDLE AVE. ELYRIA, OHIO

SURVEYED BY: JAMES A. SAYLER  
CLOSURE: 0.00 : 10.000  
MAP PAGE(S): 04-00-020-H  
APPROVED BY: JAH DATE: 6-20-01  
SCALE: 1" = 100' PRIOR INSTRUMENT: OR 58/50