


RASTER

PARENT PARCEL: 04-00-023-105-257
CHILD PARCEL: 04-00-023-105-273, -274
STARTING POINT: CENTERLINE OF SCHWARTZ RD. & SANDY LN.

NO. 00793

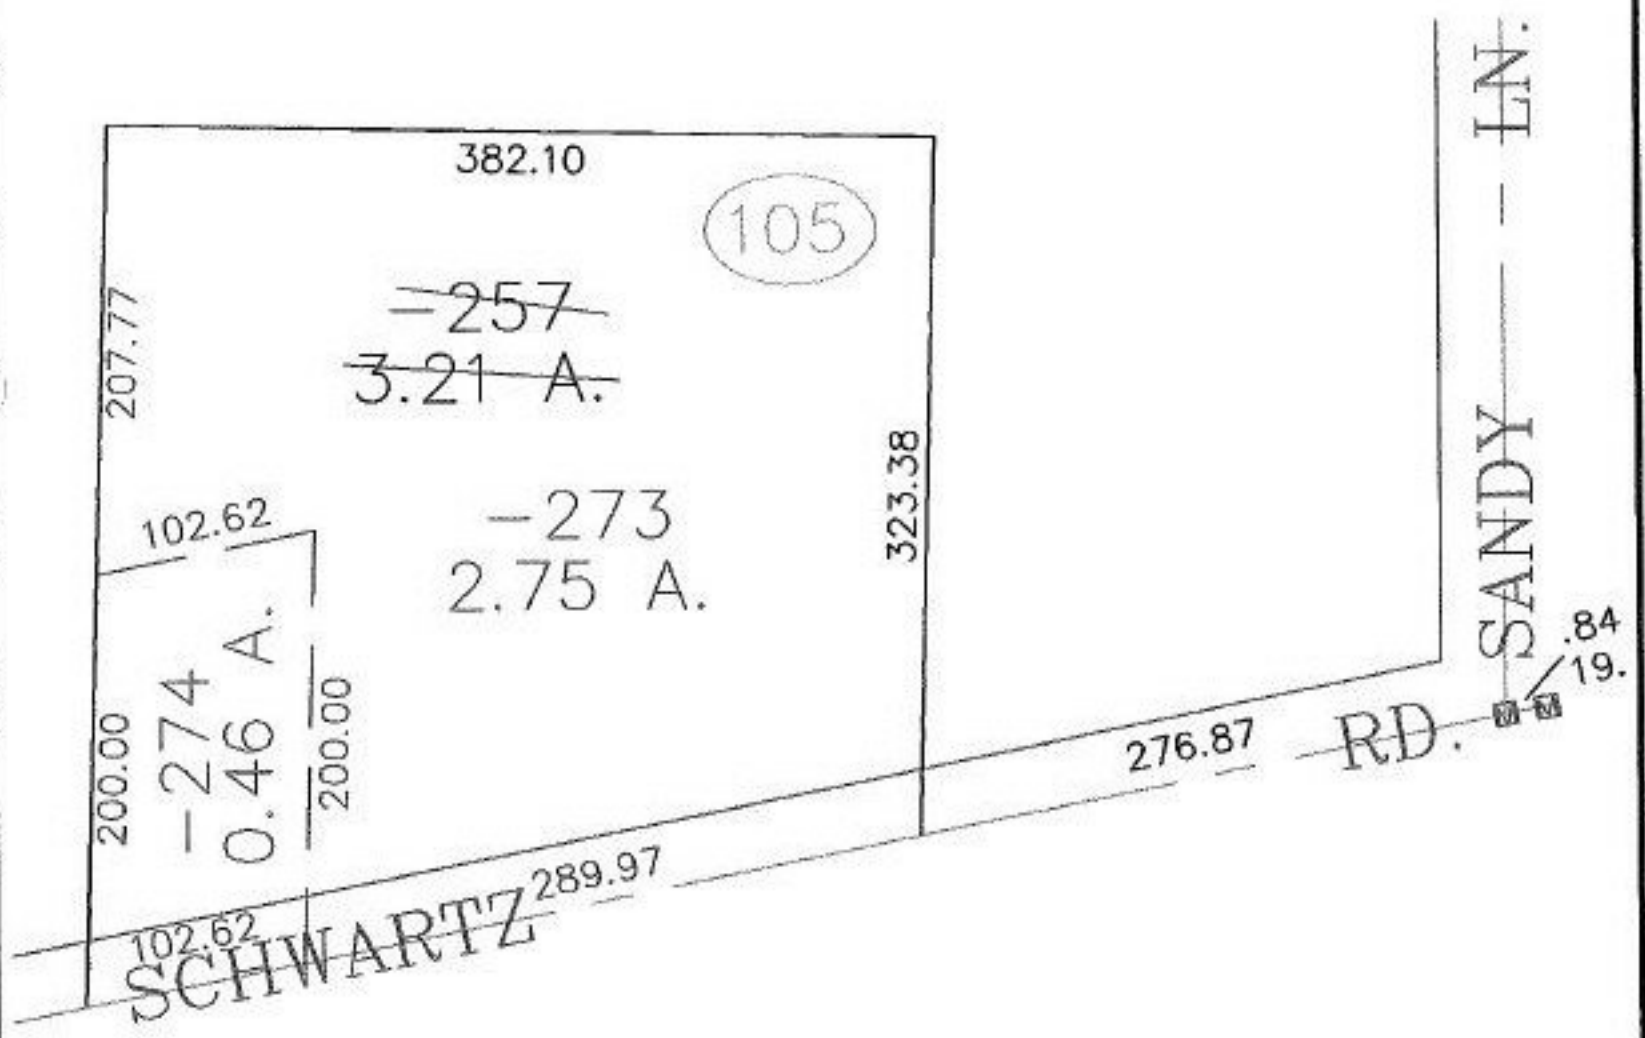

SPLITS/DEEDS PROCESSED
LORAIN COUNTY TAX MAP DEPARTMENT
226 MIDDLE AVE. ELYRIA, OHIO

SURVEYED BY: DANE A. HOPONEK
CLOSURE: 0.00 : 10.000
MAP PAGE(S): 4-00-023-G
APPROVED BY: JAH DATE: 6-22-01
SCALE: 1" = 100' PRIOR INSTRUMENT: DV 1376/563