


RASTER

NO. 00796

PARENT PARCEL: 03-00-011-102-115
CHILD PARCEL: 03-00-011-102-116 THRU -119
STARTING POINT: MON. BOX, CL OF ABBE RD. & SOUTH LINE OF O.L. 11

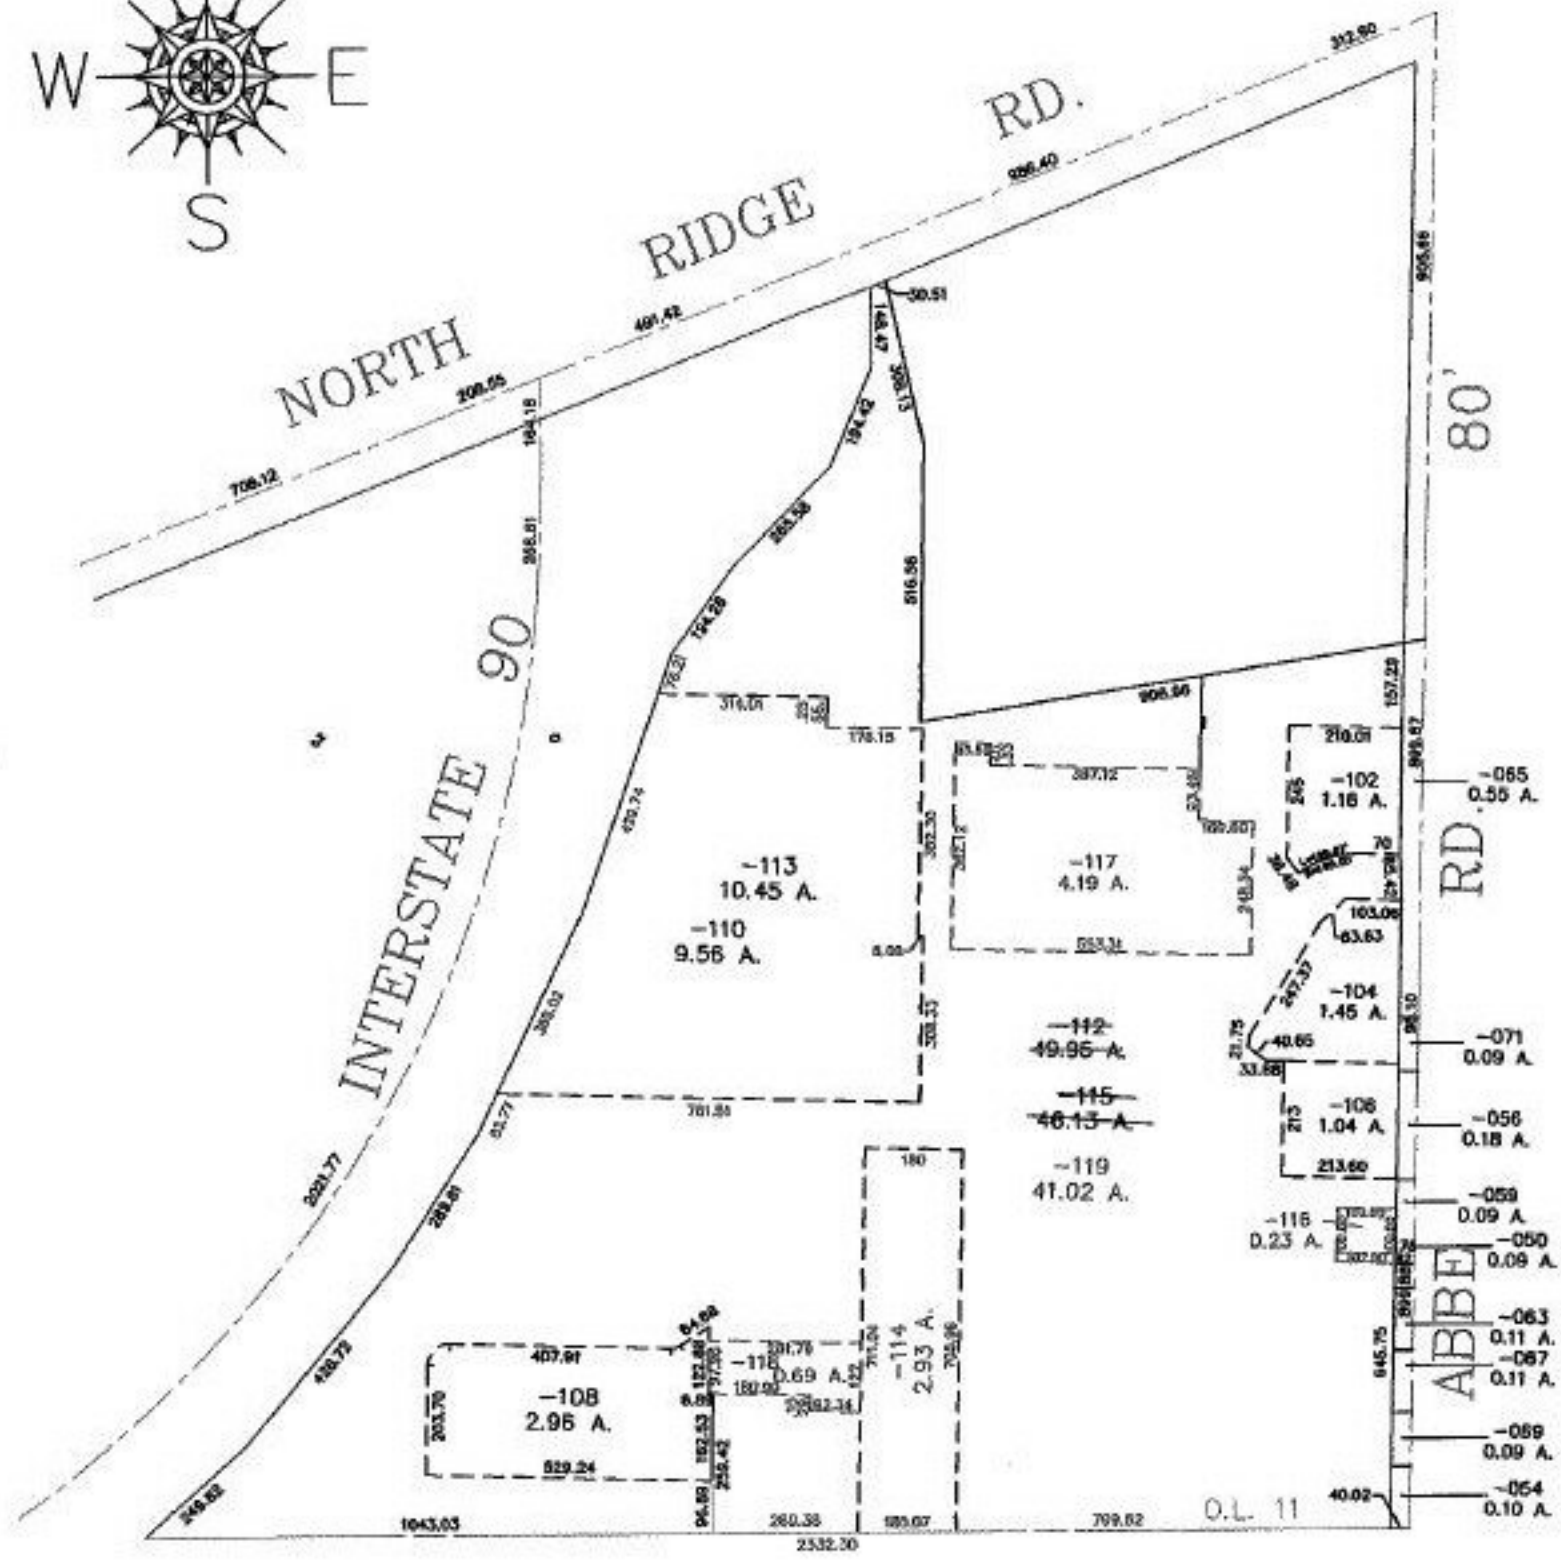

SPLITS/DEEDS PROCESSED
LORAIN COUNTY TAX MAP DEPARTMENT
226 MIDDLE AVE. ELYRIA, OHIO

SURVEYED BY: DONALD WOIKE
CLOSURE: 0.01 : 10.000
MAP PAGE(S): 3-1
APPROVED BY: JAH DATE: 6-26-01
SCALE: 1" = 400' PRIOR INSTRUMENT: 20010745002