


RASTER

PARENT PARCEL: 05-00-051-000-013

CHILD PARCEL: 05-00-051-000-014, -015

STARTING POINT: CENTERLINE OF OBERLIN RD. & ALBRECHT RD.

NO. 00798

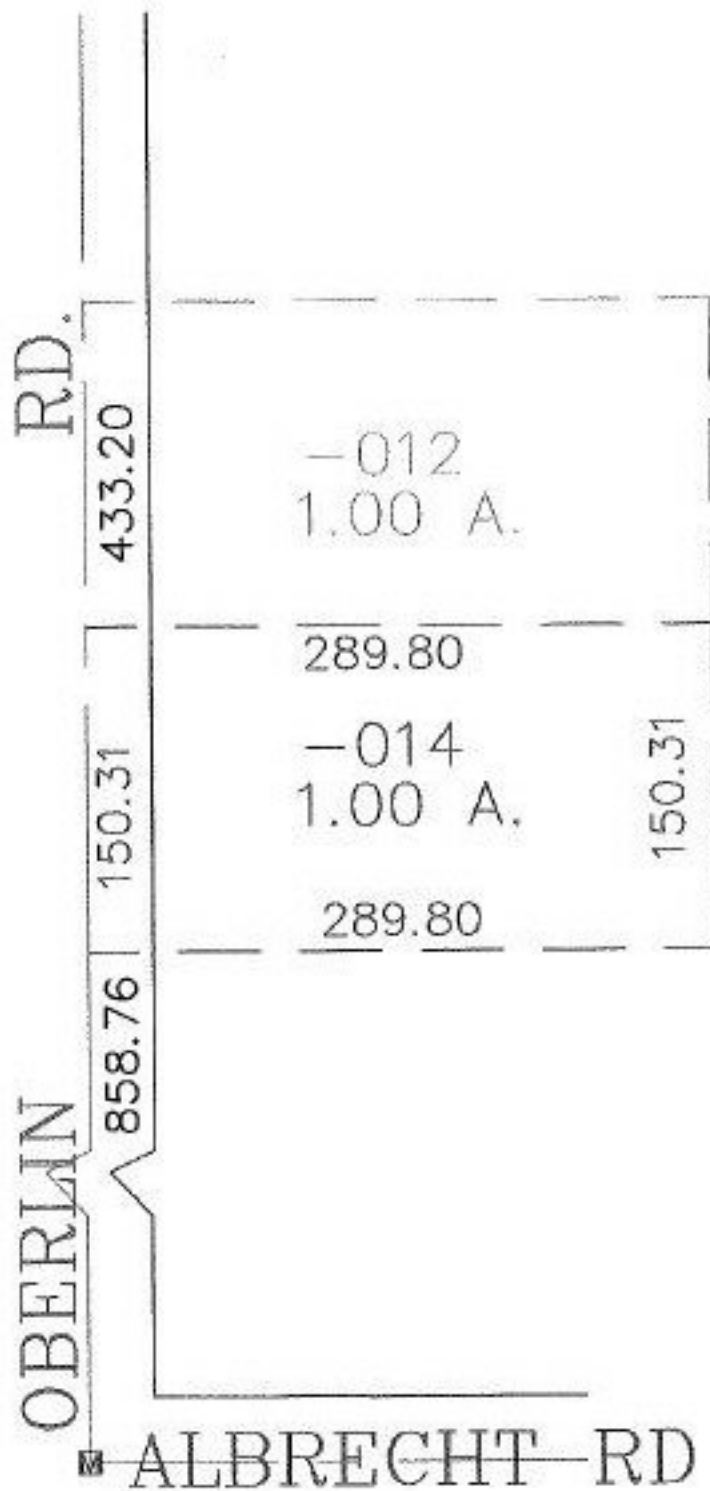

-012  
1.00 A.

289.80  
-014  
1.00 A.

289.80

~~-013~~  
~~25.93 A.~~

-015  
24.93 A.

**SPLITS/DEEDS PROCESSED**

LORAIN COUNTY TAX MAP DEPARTMENT  
226 MIDDLE AVE. ELYRIA, OHIO

SURVEYED BY: PHILIP A. ROSEBECK

CLOSURE: 0.01 : 10,000

MAP PAGE(S): 5-G

APPROVED BY: JAH DATE: 6-26-01

SCALE: 1" = 100. PRIOR INSTRUMENT: 20010739434