


RASTER

PARENT PARCEL: 12-00-024-000-024

CHILD PARCEL: 12-00-024-000-027, -028

STARTING POINT: CENTERLINE OF BOONE RD. & O.L. 24

NO. 00801

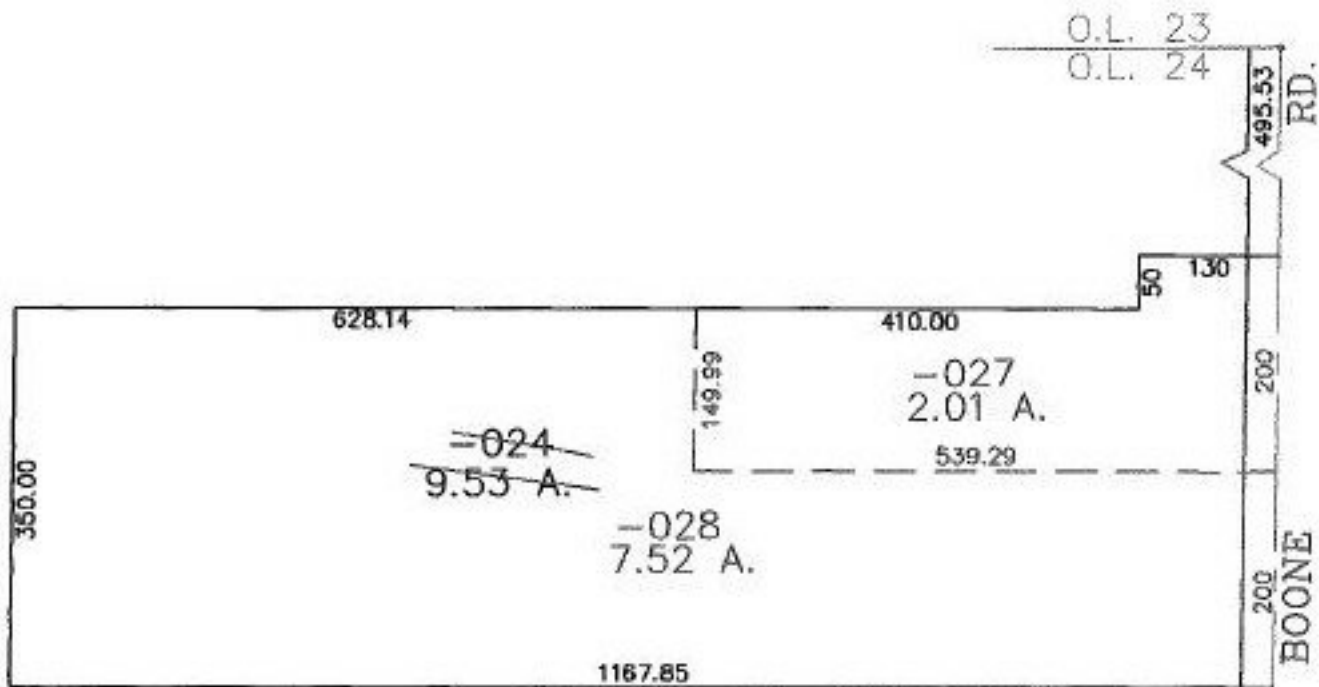

SPLITS/DEEDS PROCESSED
 LORAIN COUNTY TAX MAP DEPARTMENT
 226 MIDDLE AVE. ELYRIA, OHIO

SURVEYED BY: TIMOTHY J. FELLER
 CLOSURE: 0.00 ; 10.000
 MAP PAGE(S): 12-00-024-B
 APPROVED BY: JAH DATE: 7-3-01
 SCALE: 1" = 200 PRIOR INSTRUMENT: 20000699433