

RASTER

PARENT PARCEL: 05-00-027-000-014



CHILD PARCEL: 05-00-027-000-015, -016

STARTING POINT: CORNER OF OHIO TURNPIKE

NO. 00807



OHIO TURNPIKE

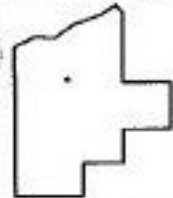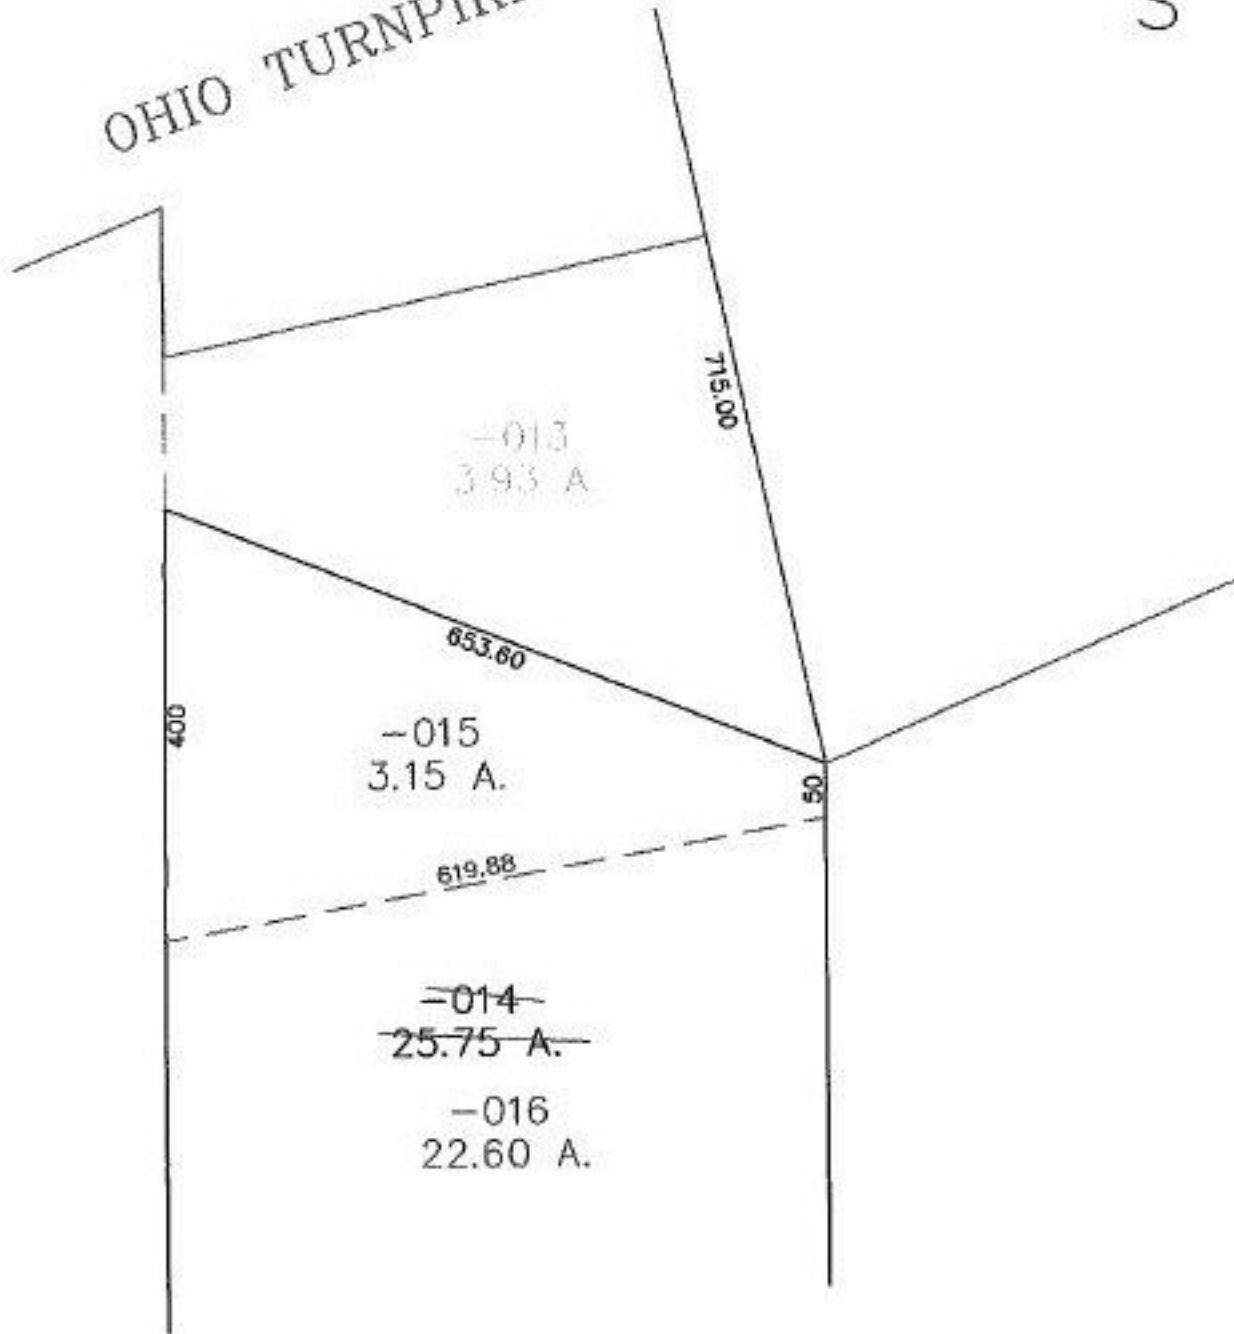

SPLITS/DEEDS PROCESSED
LORAIN COUNTY TAX MAP DEPARTMENT
226 MIDDLE AVE. ELYRIA, OHIO

SURVEYED BY: WILLIAM J. VONDRA

CLOSURE: 0.00 : 10.000

MAP PAGE(S): 5-F

APPROVED BY: JAH DATE: 7-20-01

SCALE: 1" = 200' PRIOR INSTRUMENT: DV 1164/896