
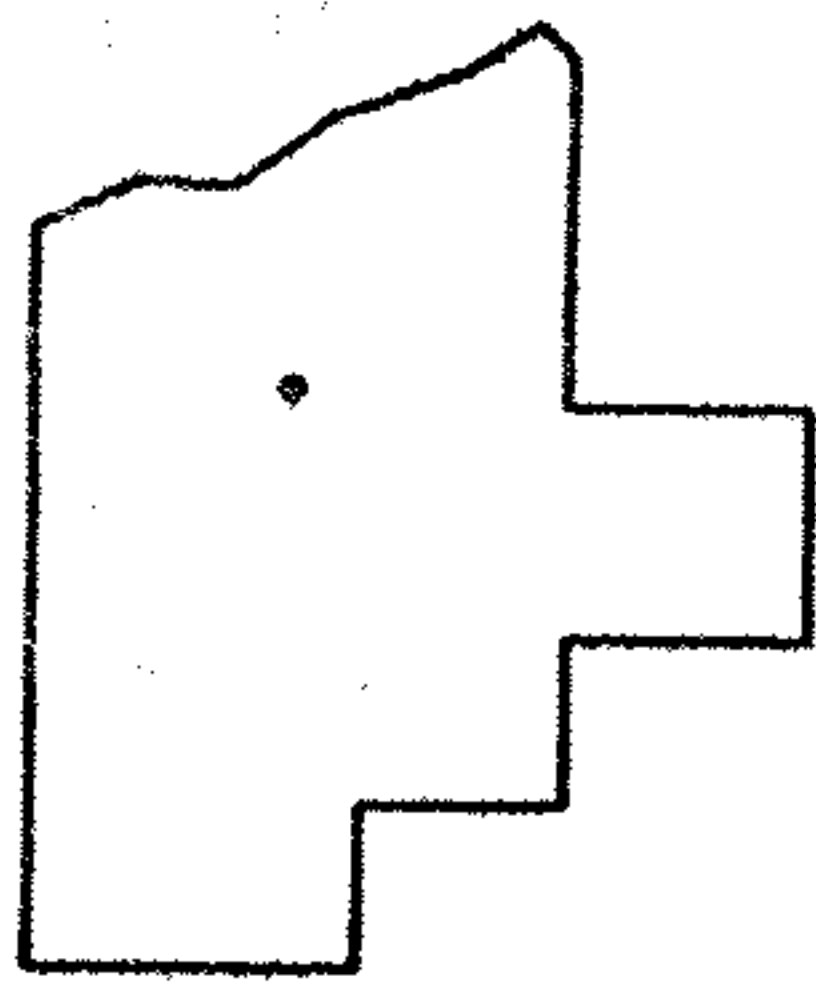
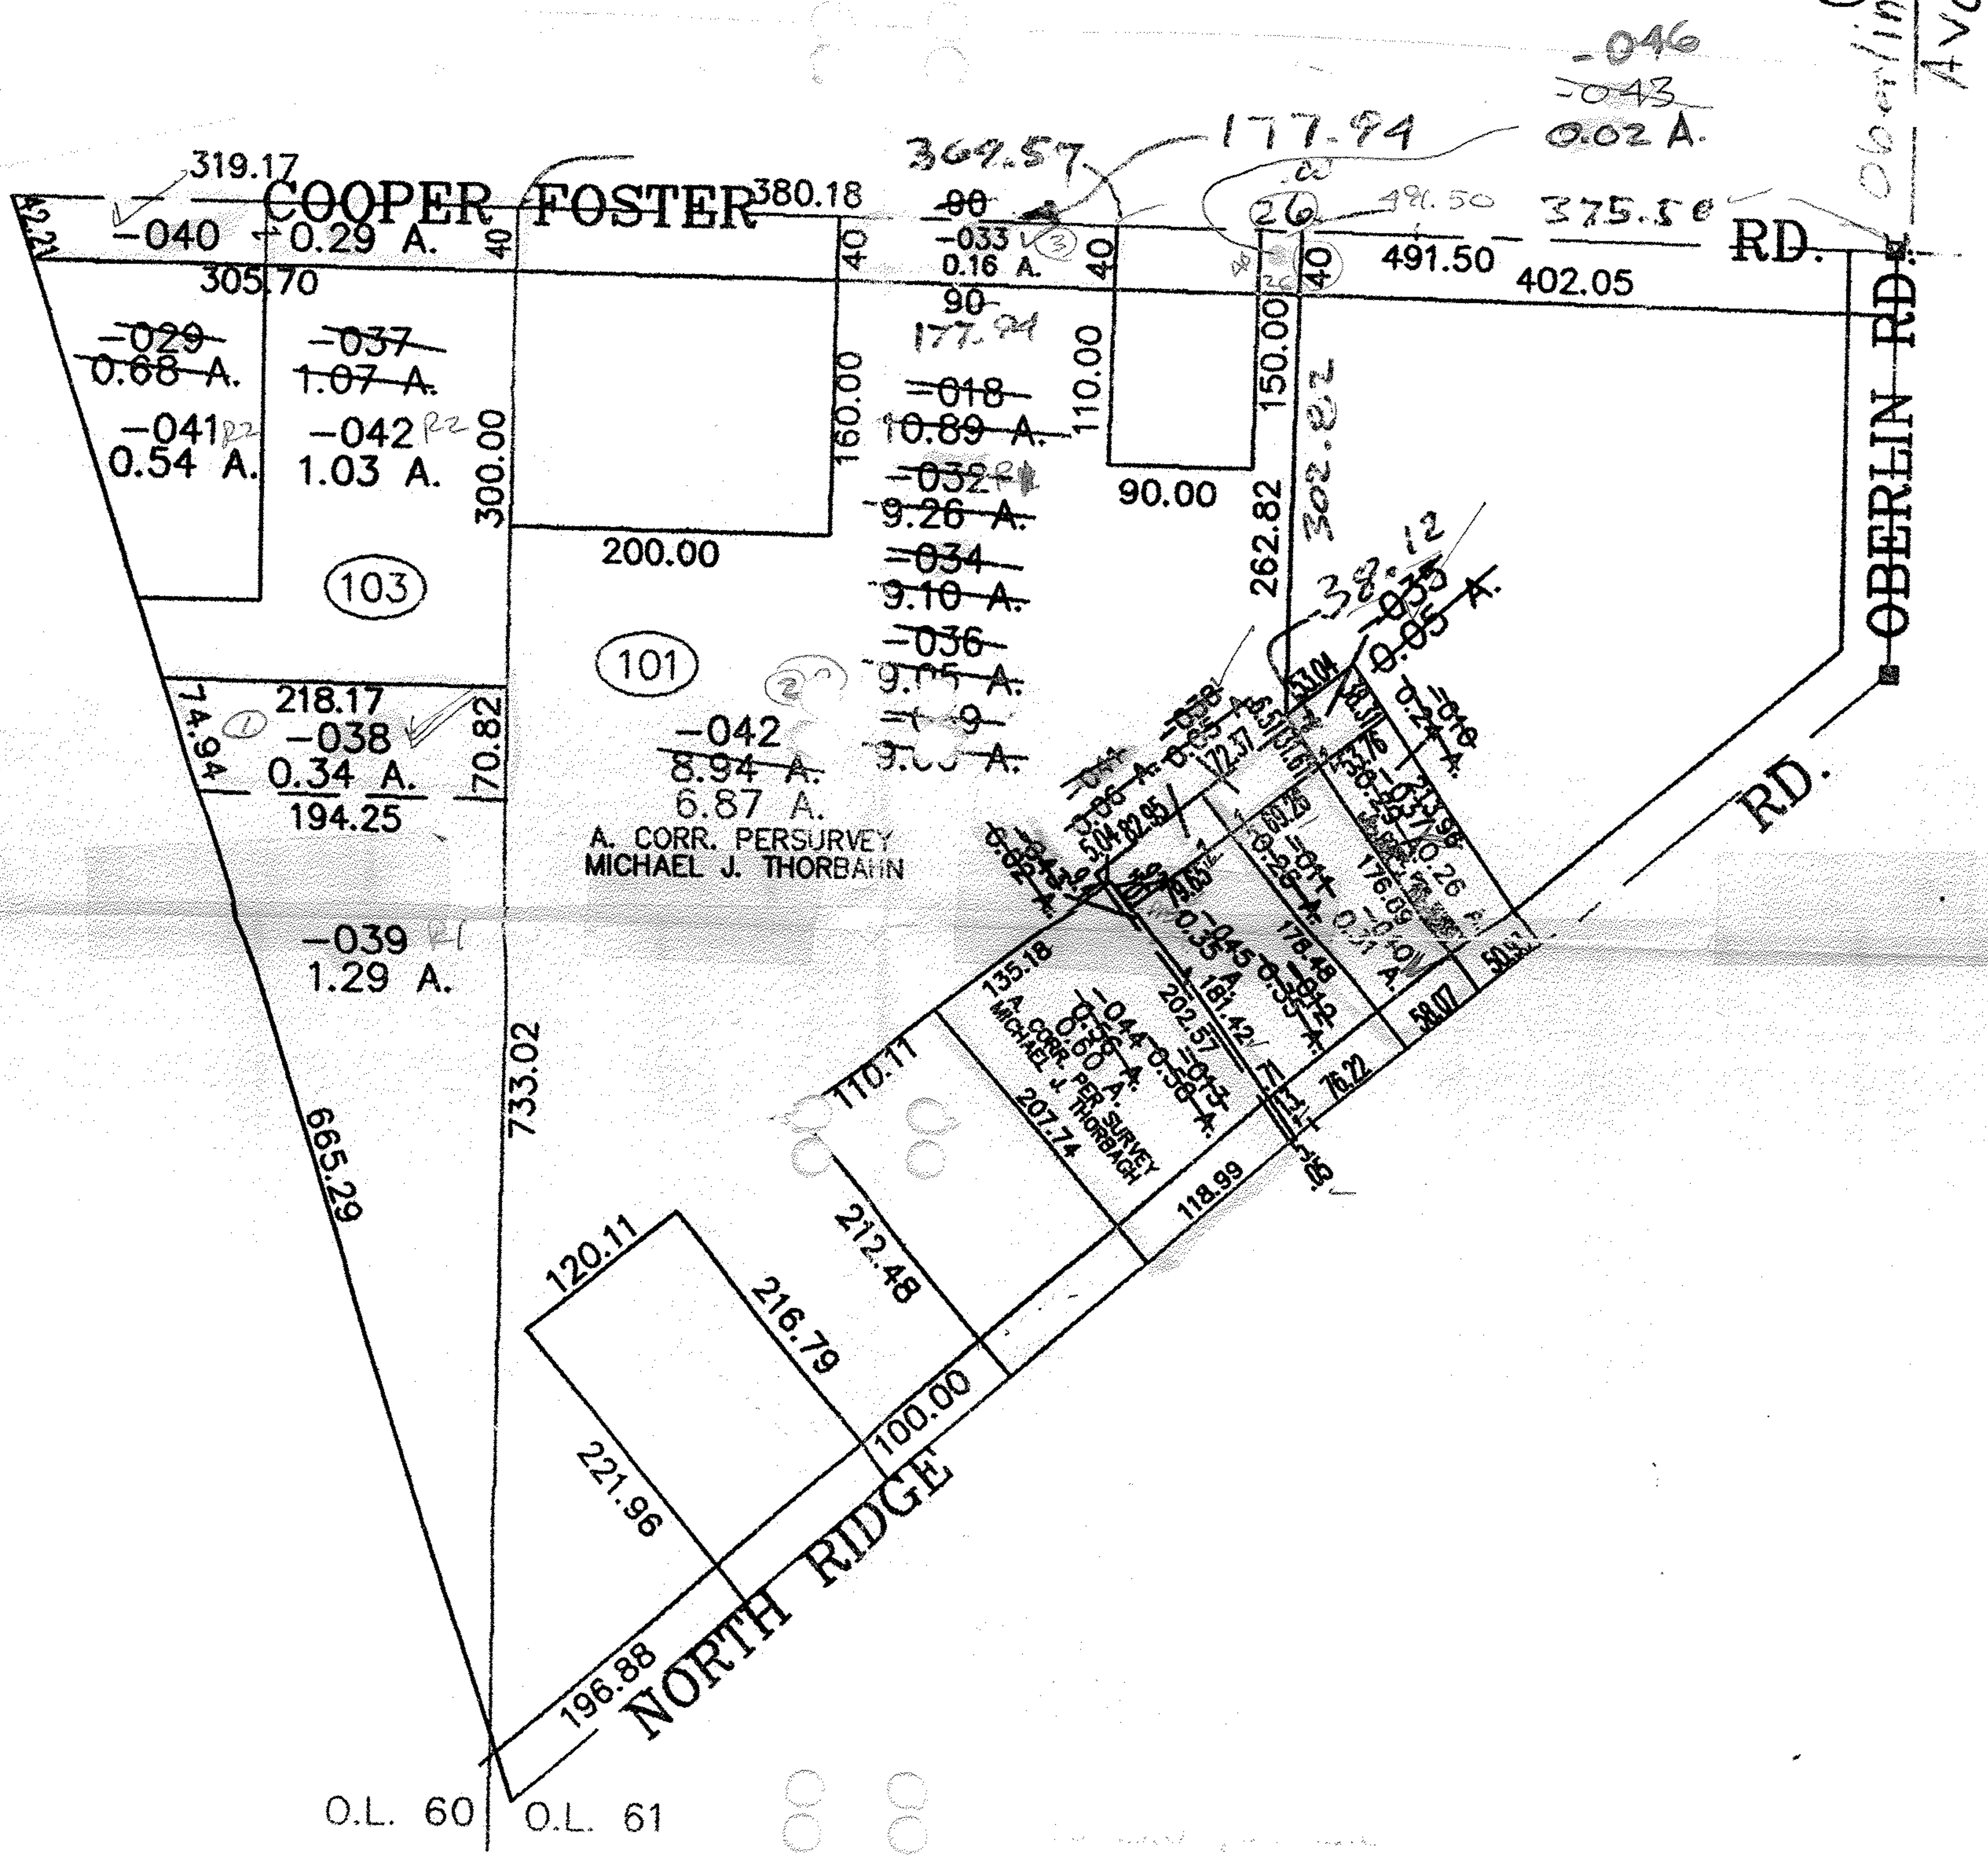


PARENT PARCEL: 05-00-061-101-018, 05-00-060-103-C 7, -C 9
 CHILD PARCEL: 05-00-060-103-038, -039 05-00-061-101-032 THRU -045
 STARTING POINT: CENTERLINE OF COOPER FOSTER RD. & OBERLIN RD.

NO. 00809

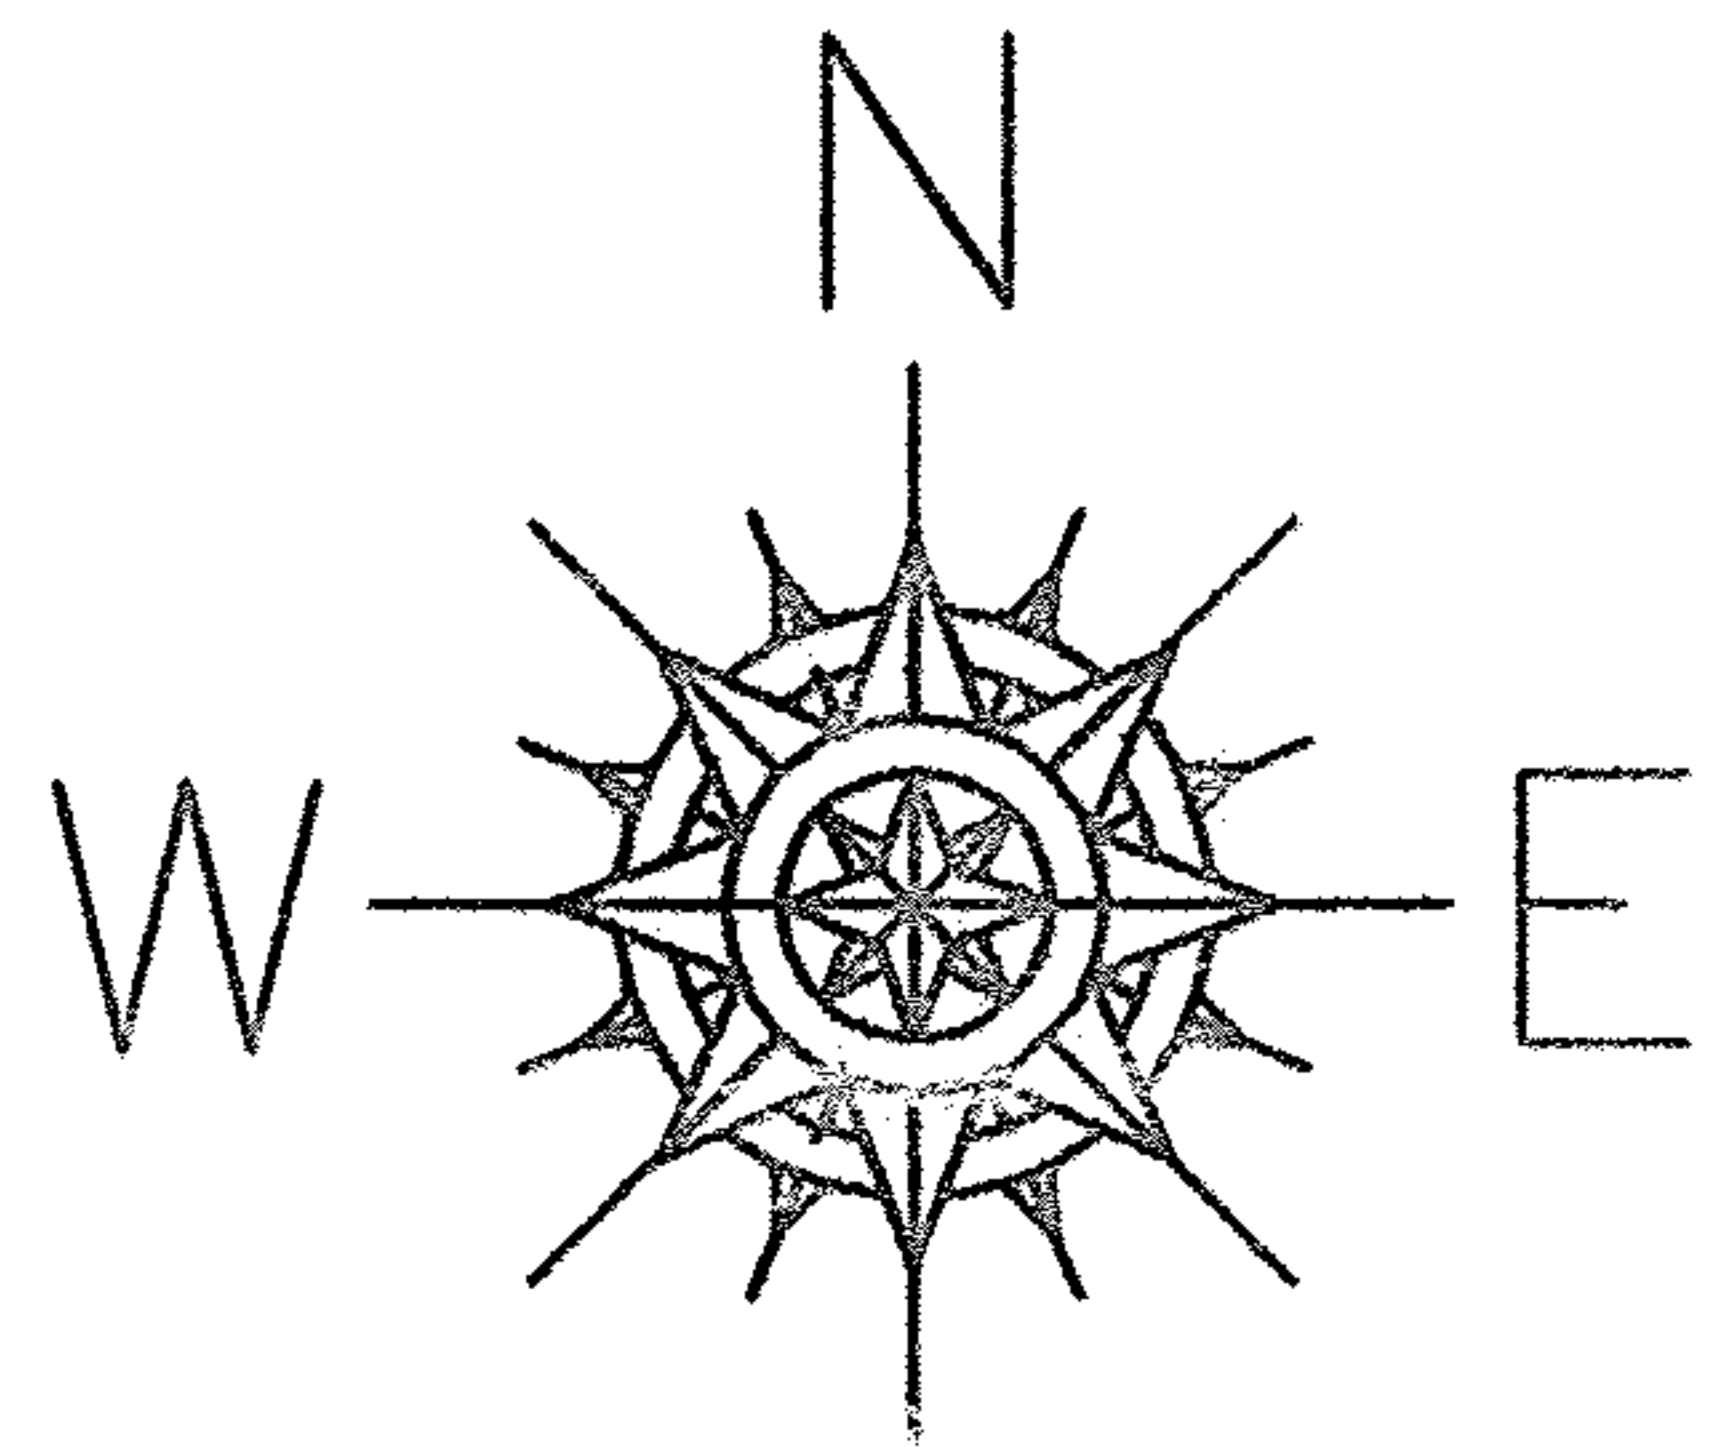

SPLITS/DEEDS PROCESSED
 LORAIN COUNTY TAX MAP DEPARTMENT
 226 MIDDLE AVE. ELYRIA, OHIO

SURVEYED BY: DAVE L. ELWELL/MICHAEL J. THORBANH
 CLOSURE: 0.00 : 10.000
 MAP PAGE(S): 05-00-060-B, -061-A
 APPROVED BY: JAH DATE: 8-15-01
 SCALE: 1" = 200 PRIOR INSTRUMENT: DV 1380/143