




PASTER

PARENT PARCEL: 05-00-053-000-051

CHILD PARCEL: 05-00-053-000-058, -059

STARTING POINT: CENTERLINE OF MILAN-ELYRIA RD. & OBERLIN RD.

NO. 00823

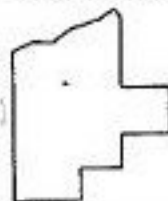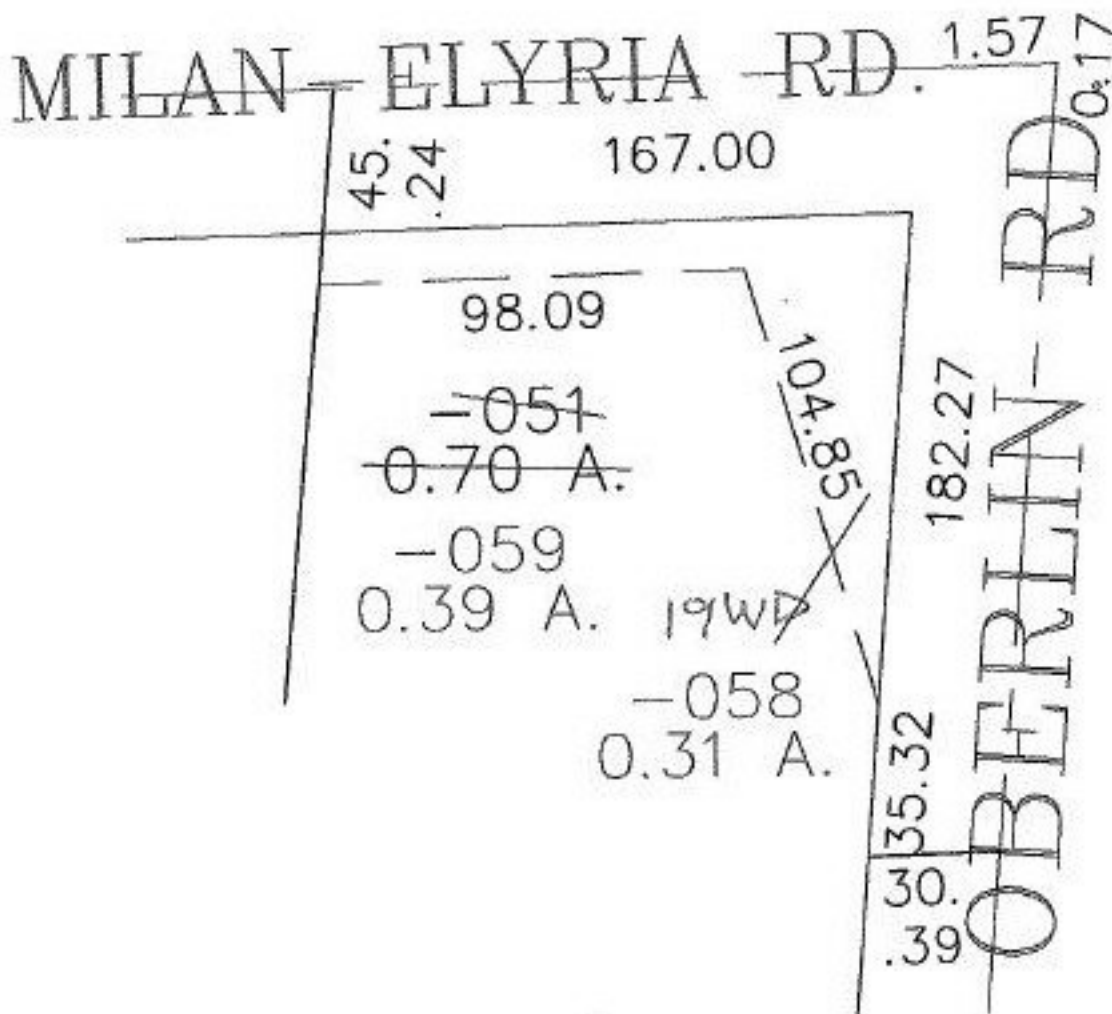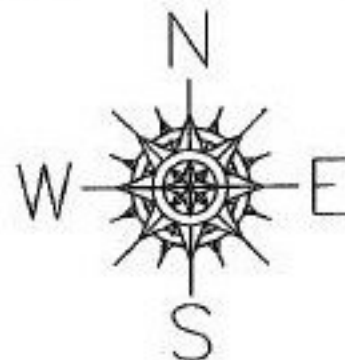

SPLITS/DEEDS PROCESSED
 LORAIN COUNTY TAX MAP DEPARTMENT
 226 MIDDLE AVE. ELYRIA, OHIO

SURVEYED BY: JAMES E. KENYON
 CLOSURE: 0.00 : 10.000
 MAP PAGE(S): 5-00-053-B
 APPROVED BY: JAH DATE: 2-27-02
 SCALE: 1" = 50' PRIOR INSTRUMENT: 990614681