



RASTER

PARENT PARCEL: 05-00-053-000-009

CHILD PARCEL: 05-00-053-000-060, -061

STARTING POINT: CENTERLINE MILAN-ELYRIA RD. & OBERLIN RD.

NO. 00824

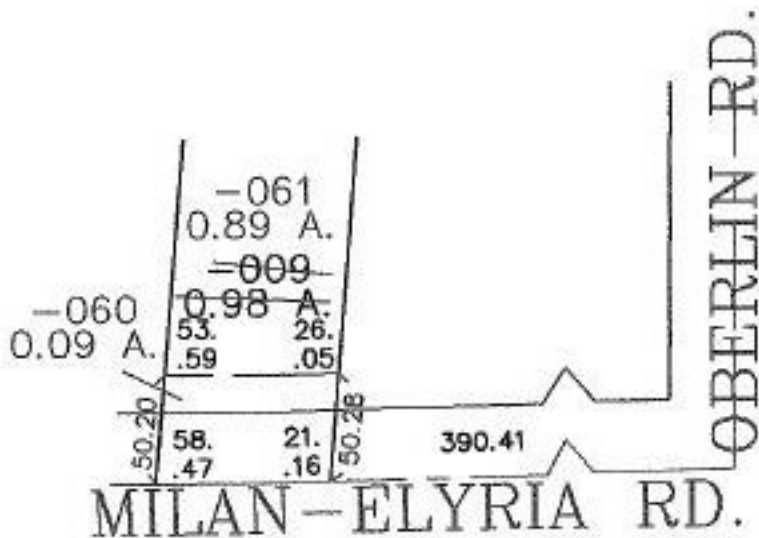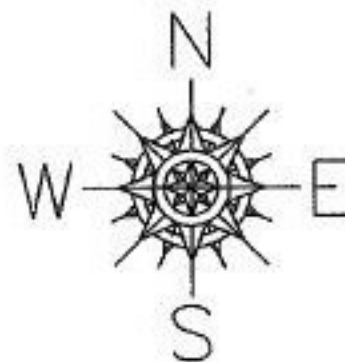

SPLITS/DEEDS PROCESSED

LORAIN COUNTY TAX MAP DEPARTMENT
226 MIDDLE AVE. ELYRIA, OHIO

SURVEYED BY: JAMES E. KENYON

CLOSURE: 0.00 : 10.000

MAP PAGE(S): 5-00-053-B

APPROVED BY: JAH DATE: 2-27-02

SCALE: 1" = 100' PRIOR INSTRUMENT: OR 1459/263