



MASTER

PARENT PARCEL: 05-00-053-000-029

CHILD PARCEL: 05-00-053-000-062, -063

STARTING POINT: CENTERLINE OF MILAN-ELYRIA RD. & OBERLIN RD.

NO. 00825

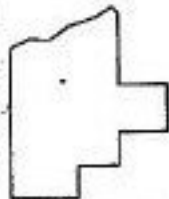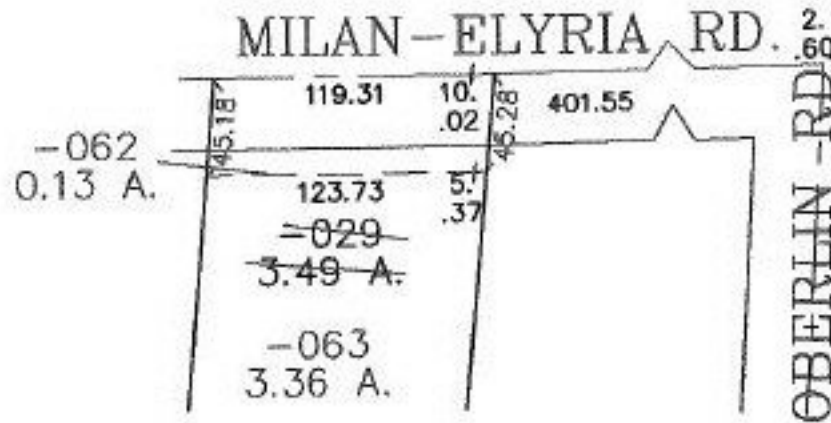

**SPLITS/DEEDS PROCESSED**  
**LORAIN COUNTY TAX MAP DEPARTMENT**  
 226 MIDDLE AVE. ELYRIA, OHIO

SURVEYED BY: JAMES E. KENYON  
 CLOSURE: 0.00 : 10.000  
 MAP PAGE(S): 5-00-053-B  
 APPROVED BY: JAH DATE: 2-28-02  
 SCALE: 1" = 100' PRIOR INSTRUMENT: 20020803183