

EASTER

PARENT PARCEL: 21-11-000-000-008

CHILD PARCEL: 21-11-000-000-016, -017

STARTING POINT: CENTERLINE OF ASHLAND-OBERLIN RD. & NEW LONDON-LAFAYETTE RD.

NO. 00829




NEW LONDON-LAFAYETTE RD.

RD.

493.44

ASHLAND-OBERLIN RD. 481.20


ASHLAND-OBERLIN RD. 481.20

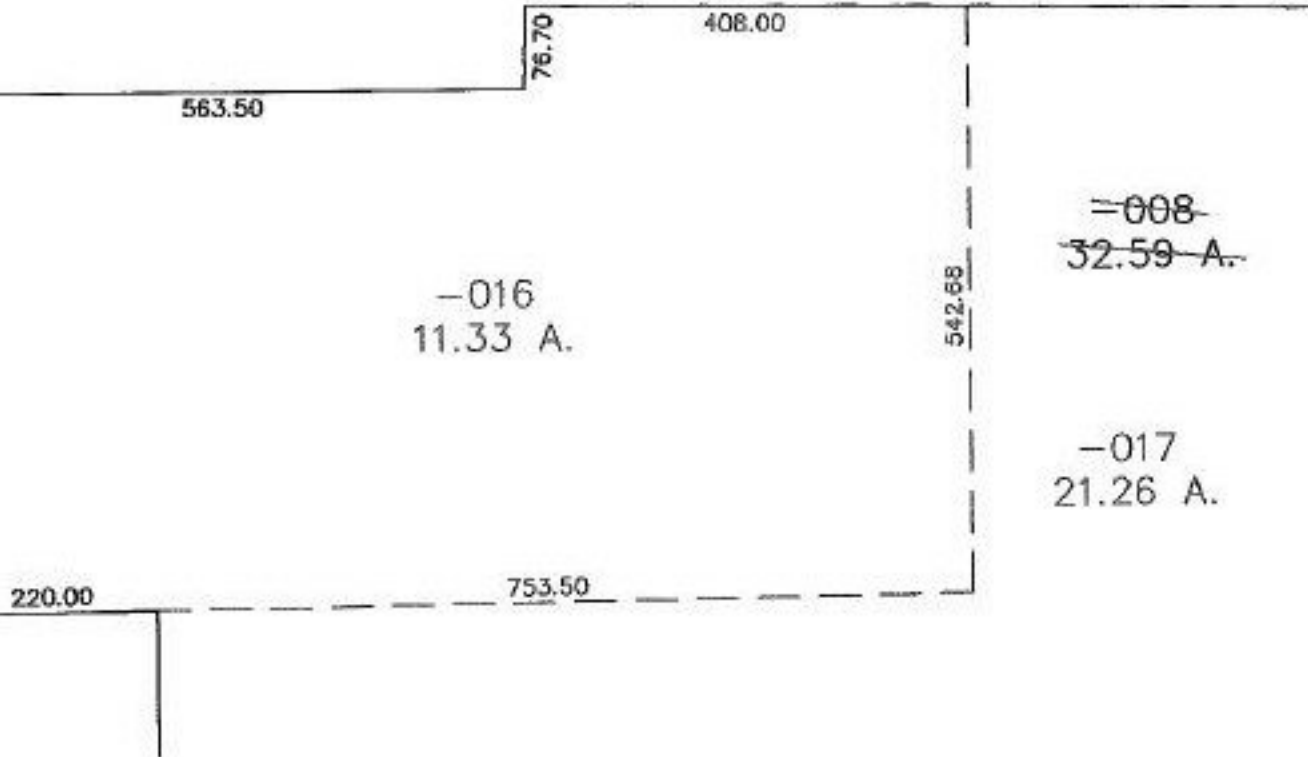

-016  
11.33 A.

~~=008~~  
~~32.59 A.~~

-017  
21.26 A.

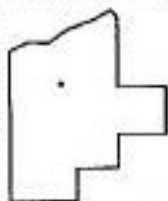

**SPLITS/DEEDS PROCESSED**  
LORAIN COUNTY TAX MAP DEPARTMENT  
226 MIDDLE AVE. ELYRIA, OHIO

SURVEYED BY: KENNETH P. CARNEY  
CLOSURE: 0.00 : 10.000  
MAP PAGE(S): 21-11-000-A  
APPROVED BY: JAH DATE: 7-31-01  
SCALE: 1" = 200' PRIOR INSTRUMENT: 20010733133