


RASTER

PARENT PARCEL: 04-00-006-135-072, -073

CHILD PARCEL: 04-00-006-135-108 THRU 110

STARTING POINT: CENTERLINE OF WALKER RD. & MOORE RD.

NO. 00831

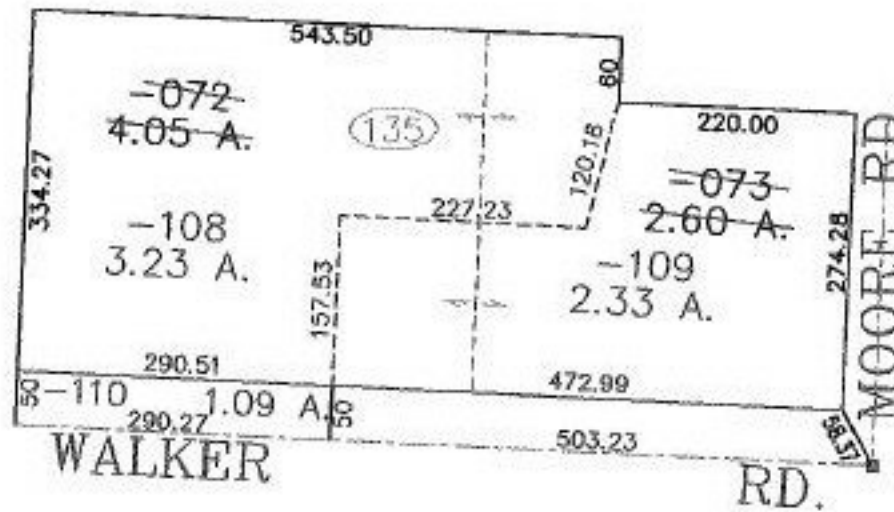

**SPLITS/DEEDS PROCESSED**  
 LORAIN COUNTY TAX MAP DEPARTMENT  
 226 MIDDLE AVE. ELYRIA, OHIO

SURVEYED BY: RALPH M. GUGAR  
 CLOSURE: 0.00 : 10.000  
 MAP PAGE(S): 4-00-006-11  
 APPROVED BY: JAH DATE: 8-15-01  
 SCALE: 1" = 200' PRIOR INSTRUMENT: DV 314/609