


EASTER

PARENT PARCEL: 03-00-108-111-053

CHILD PARCEL: 03-00-108-111-072, -073, -074


STARTING POINT: CORNER OF SUBLLOT 31

NO. 00837

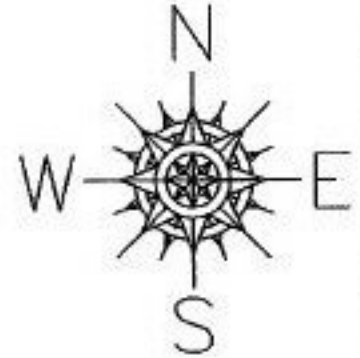

# HILLS ALLOT.

VOL 19 PG. 7

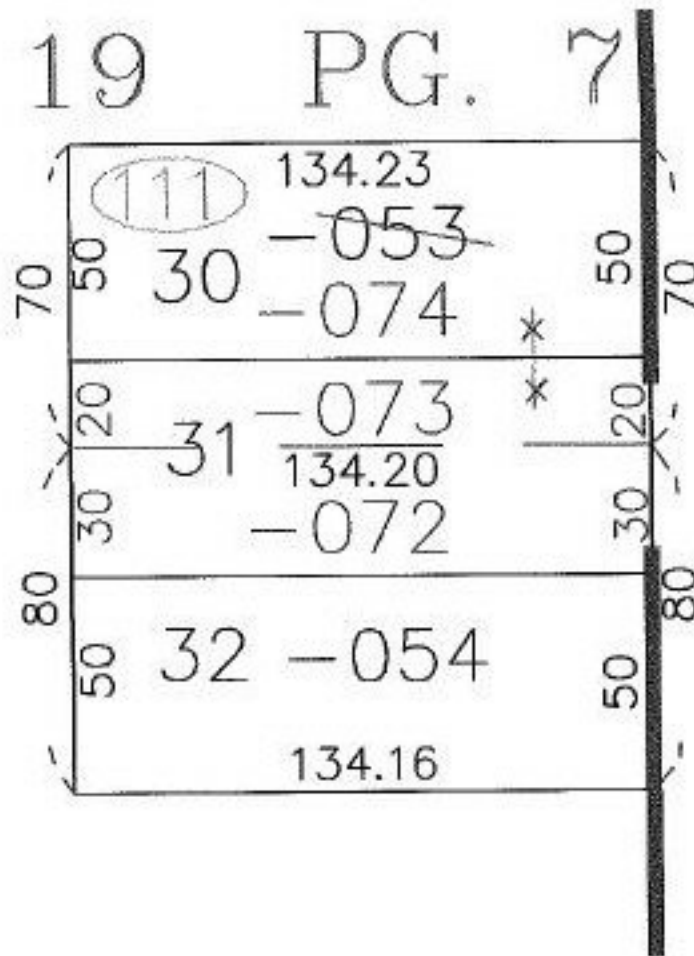

**SPLITS/DEEDS PROCESSED**  
**LORAIN COUNTY TAX MAP DEPARTMENT**  
 226 MIDDLE AVE. ELYRIA, OHIO

SURVEYED BY: JOHN CLOUD SKONIECZNY  
 CLOSURE: 0.00 : 10.000  
 MAP PAGE(S): 03-00-108-B  
 APPROVED BY: JAH DATE: 8-8-01  
 SCALE: 1" = 50' PRIOR INSTRUMENT: 970479174