
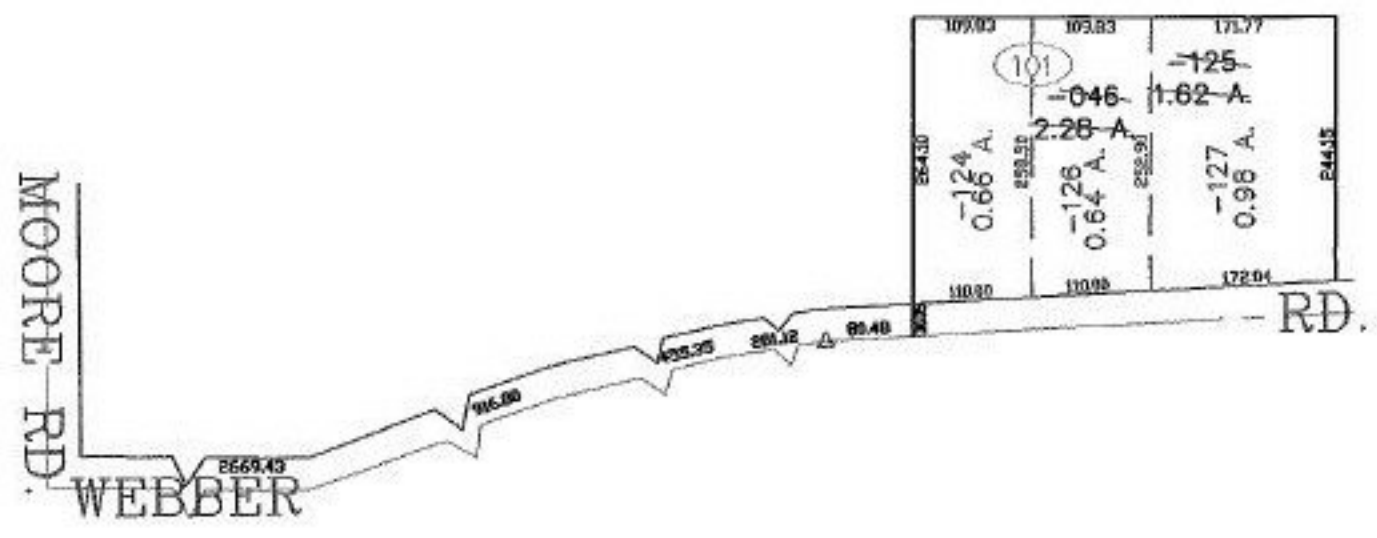


RASTER

PARENT PARCEL: 04-00-008-101-046
CHILD PARCEL: 04-00-008-101-124 THRU -127
STARTING POINT: XXXXXX

NO. 00838

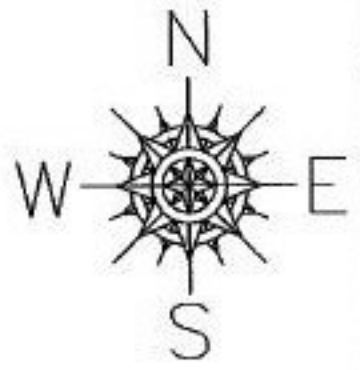

SPLITS/DEEDS PROCESSED
LORAIN COUNTY TAX MAP DEPARTMENT
226 MIDDLE AVE. ELYRIA, OHIO

SURVEYED BY: JOHN H. CRAWFORD IV
CLOSURE: 0.00 : 10.000
MAP PAGE(S): 4-B
APPROVED BY: JAH DATE: 8-13-01
SCALE: 1" = 200 PRIOR INSTRUMENT: 20000723732