


RASIER

PARENT PARCEL: 11-00-019-000-037

CHILD PARCEL: 11-00-019-000-043, -044

STARTING POINT: CENTERLINE OF COWLEY RD. & O.L. 19

NO. 00846

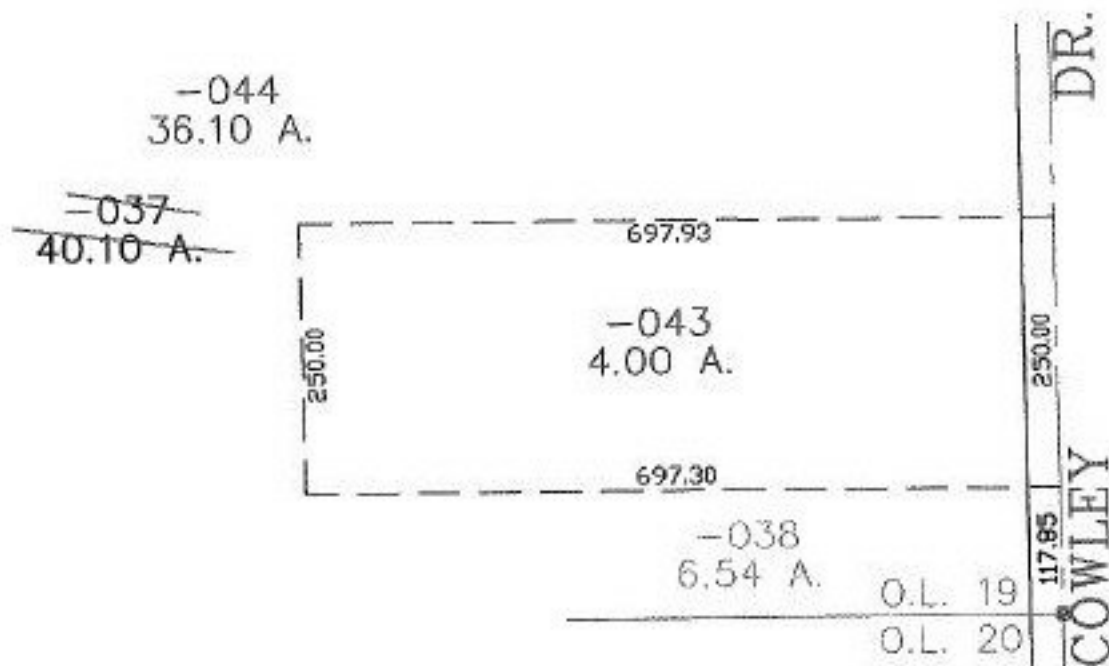

**SPLITS/DEEDS PROCESSED**  
 LORAIN COUNTY TAX MAP DEPARTMENT  
 226 MIDDLE AVE. ELYRIA, OHIO

SURVEYED BY: RICHARD D. CARLSON  
 CLOSURE: 0.00 ; 10.000  
 MAP PAGE(S): 11-00-019-A, B  
 APPROVED BY: JAH DATE: 8-16-01  
 SCALE: 1" = 200' PRIOR INSTRUMENT: 20000696675