


PARENT PARCEL: 07-00-032-000-043, -031, -010
CHILD PARCEL: 07-00-032-000-055 THRU -062
STARTING POINT: CORNER OF O.L. 32 & O.L. 33 & O.L. 29 & O.L. 28

NO. 00853

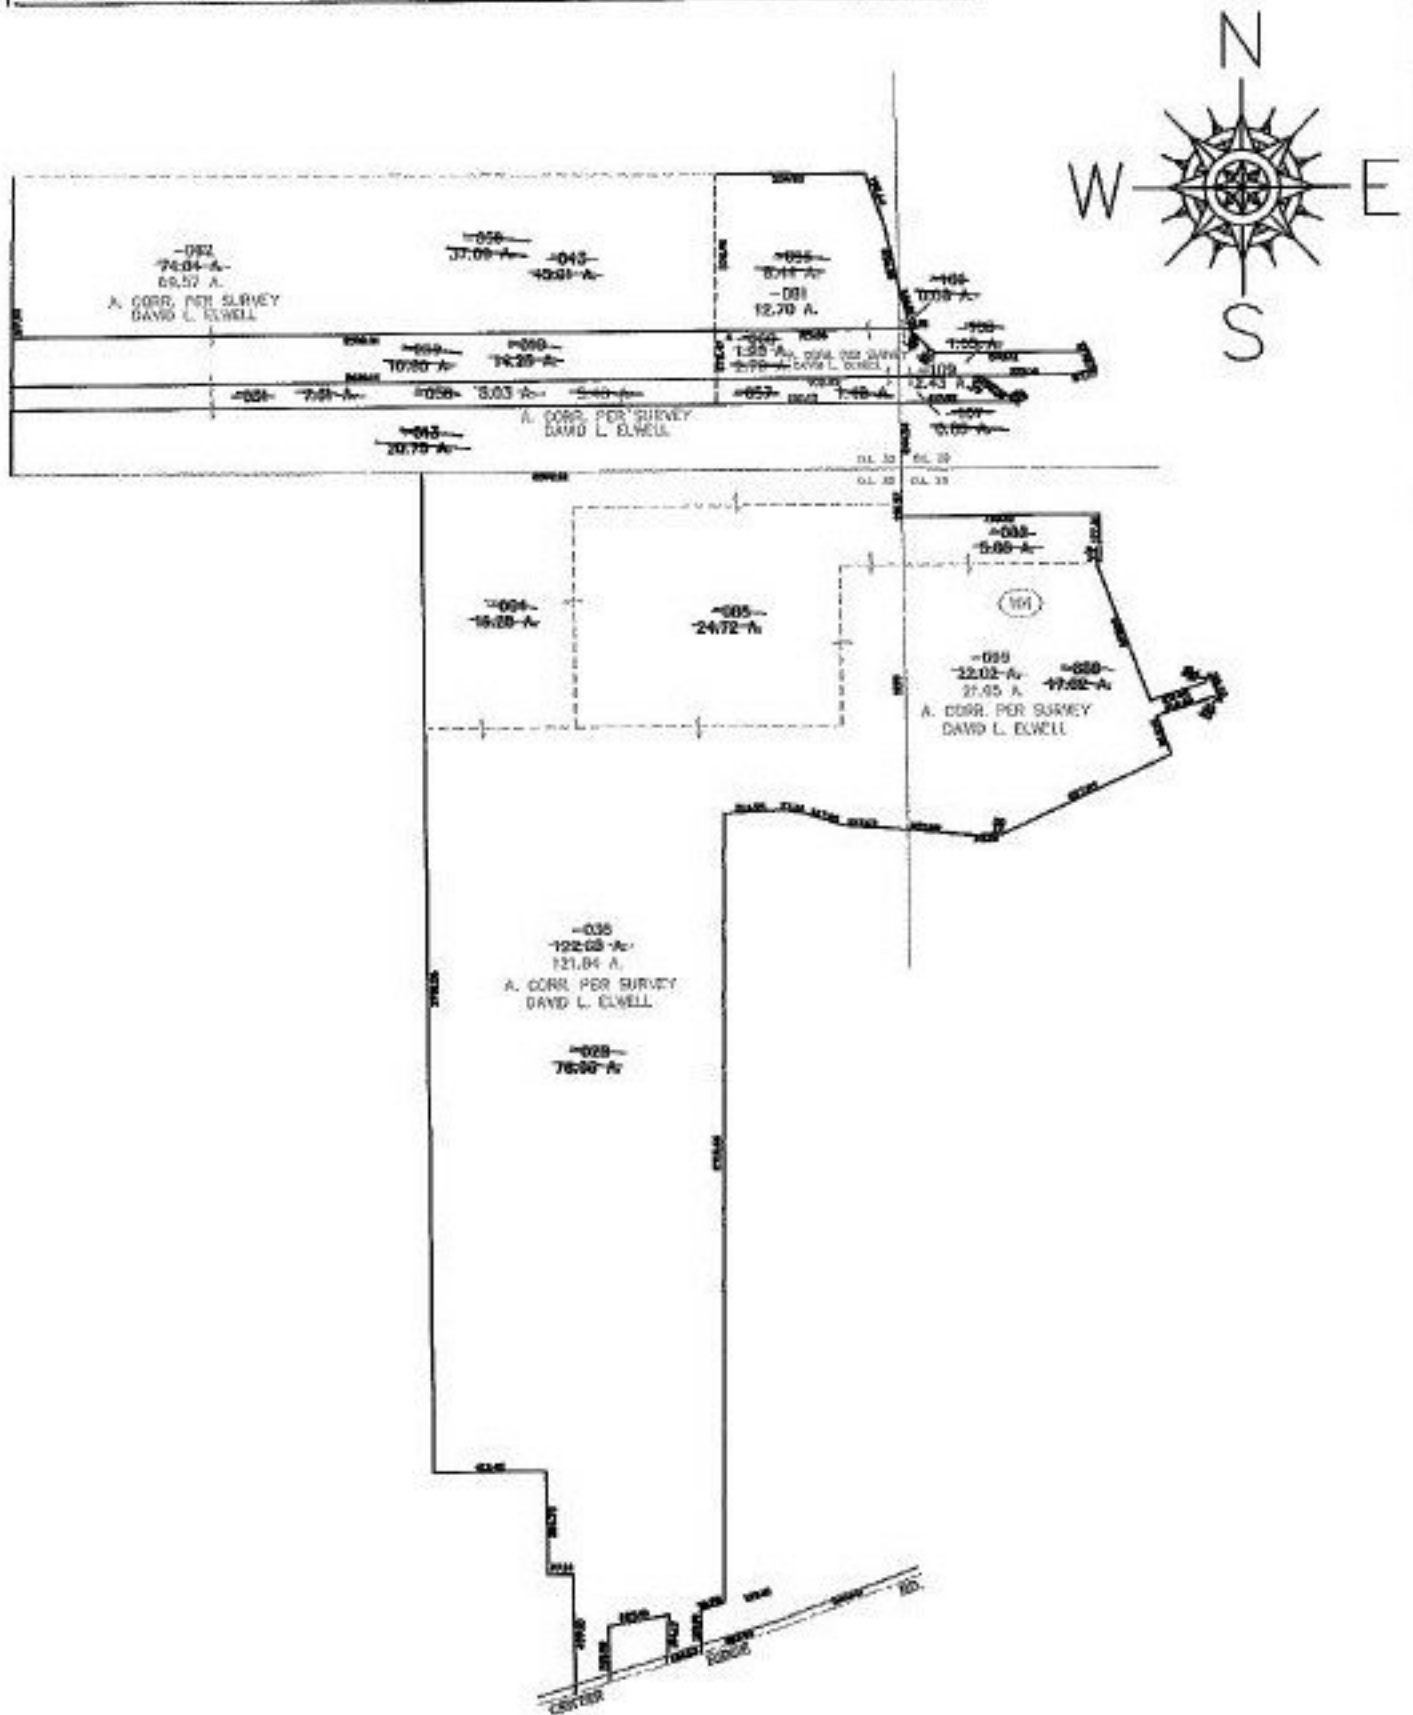

SPLITS/DEEDS PROCESSED

LORAIN COUNTY TAX MAP DEPARTMENT
226 MIDDLE AVE. ELYRIA, OHIO

SURVEYED BY: DAVID L. ELWELL
CLOSURE: 0.00 : 10.000
MAP PAGE(S): 7-B
APPROVED BY: JAH DATE: 8-23-01
SCALE: 1" = 800 PRIOR INSTRUMENT: 980586193