


EASTER

PARENT PARCEL: 07-00-022-101-032

CHILD PARCEL: 07-00-022-101-085, -086

STARTING POINT: CENTERLINE OF WOOSTER-AVON LAKE RD. & O.L. 22

NO. 00857

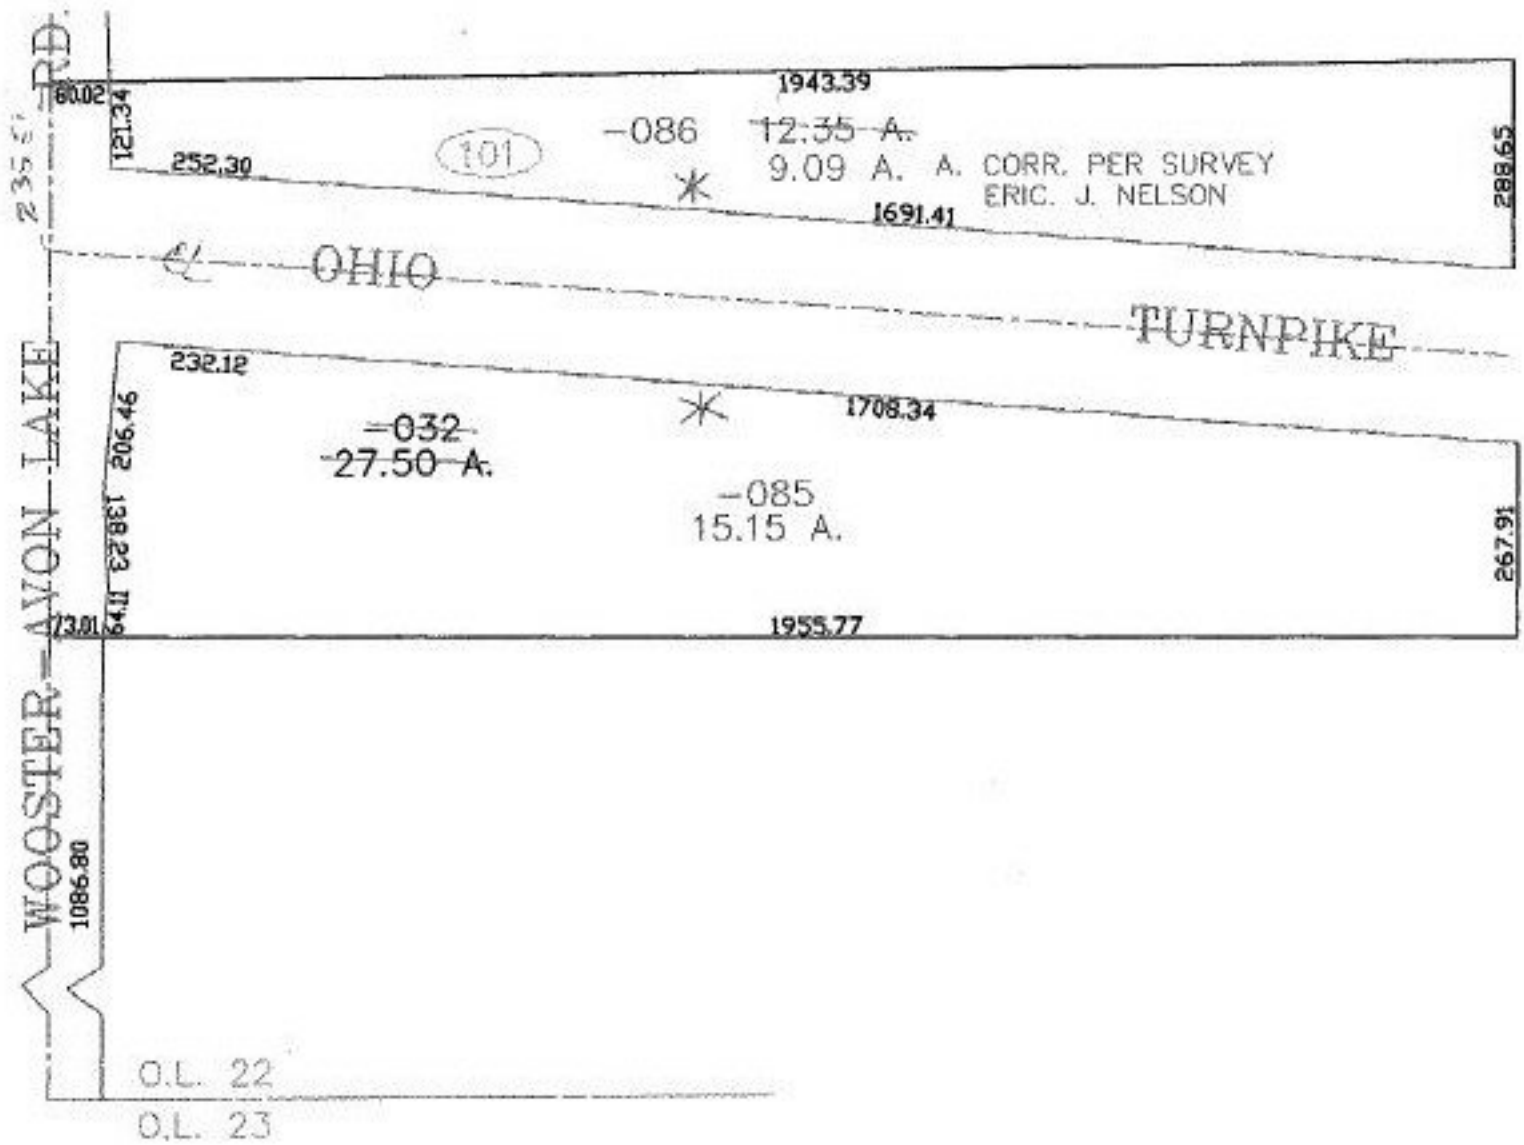

SPLITS/DEEDS PROCESSED

LORAIN COUNTY TAX MAP DEPARTMENT
226 MIDDLE AVE. ELYRIA, OHIO

SURVEYED BY: ERIC J. NELSON

CLOSURE: 0.00 : 10.000

MAP PAGE(S): 7-00-022-C

APPROVED BY: JAH DATE: 10-17-01

SCALE: 1" = 300' PRIOR INSTRUMENT: OR 1050/413