


RASTER

PARENT PARCEL: 02-03-007-000-193, -222  
CHILD PARCEL: 02-03-007-000-227 THRU -230  
STARTING POINT: NORTHEAST CORNER OF BLOCK "C"

NO. 00866

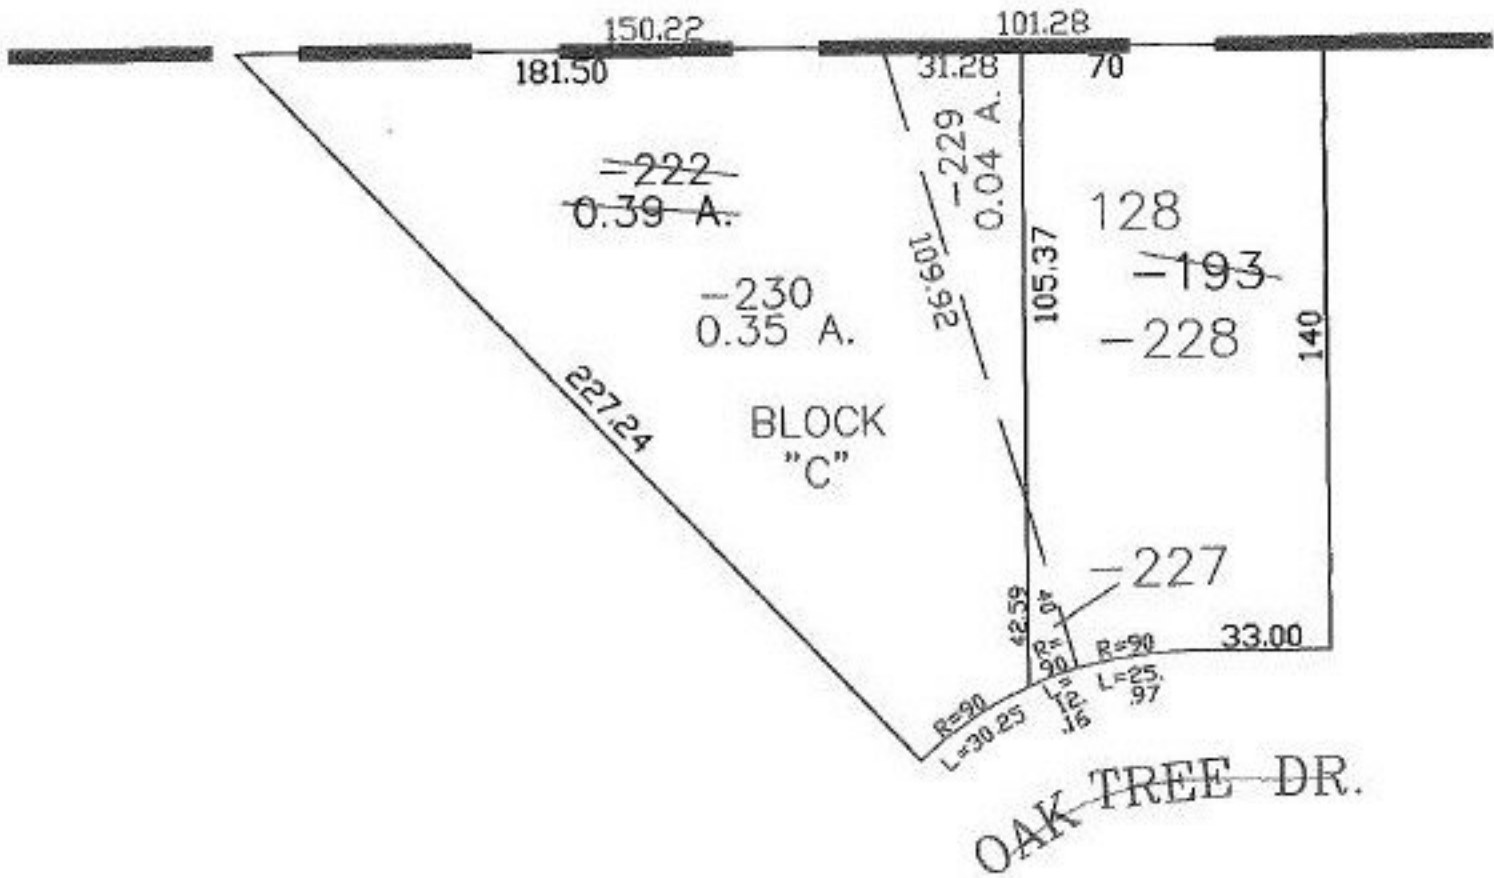

OAK TREE DR.



**SPLITS/DEEDS PROCESSED**  
LORAIN COUNTY TAX MAP DEPARTMENT  
226 MIDDLE AVE. ELYRIA, OHIO

SURVEYED BY: DAVID L. ELWELL  
CLOSURE: 0.00 : 10.000  
MAP PAGE(S): 2-03-007-A  
APPROVED BY: JAH DATE: 9-18-01  
SCALE: 1" = 50' PRIOR INSTRUMENT: OR 65/10