
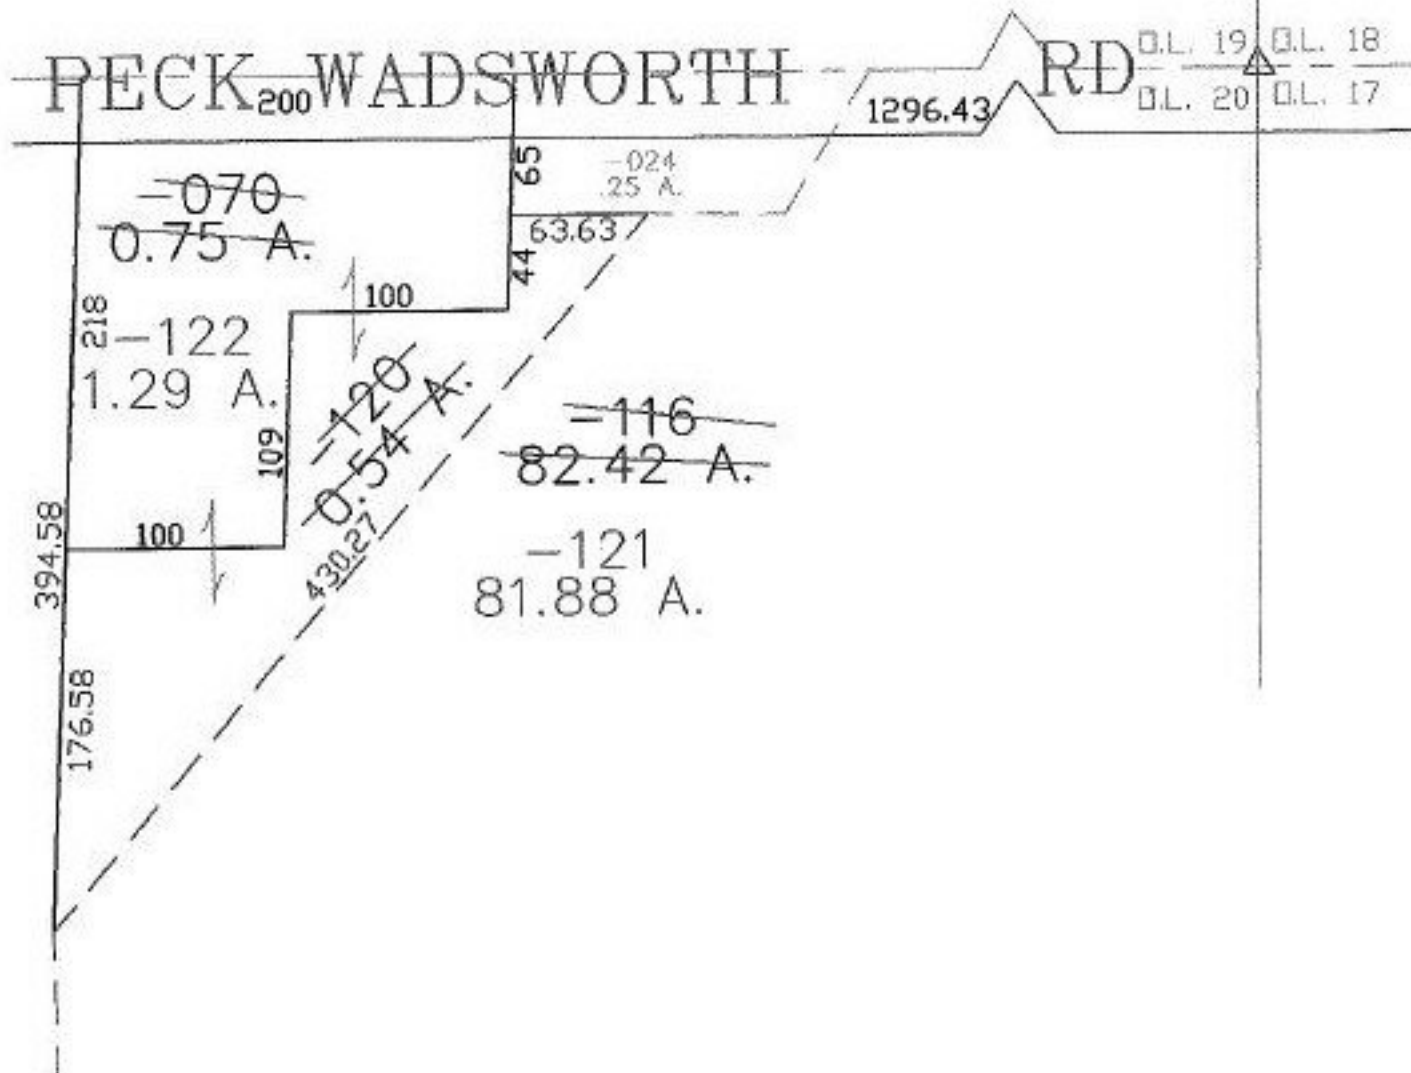


PARENT PARCEL: 18-00-020-000-116, -070
CHILD PARCEL: 18-00-020-000-120 THRU -122
STARTING POINT: CENTERLINE OF PECK WADSWORTH & O.L. 20

NO. 00867

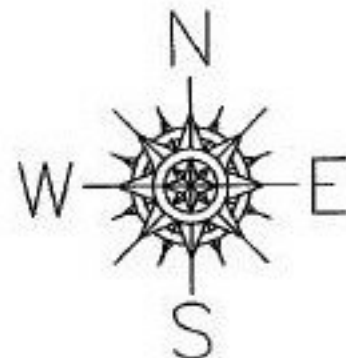

SPLITS/DEEDS PROCESSED
LORAIN COUNTY TAX MAP DEPARTMENT
226 MIDDLE AVE. ELYRIA, OHIO

SURVEYED BY: RICHARD D. CARLSON
CLOSURE: 0.00 : 10.000
MAP PAGE(S): 18-00-020-A
APPROVED BY: JAH DATE: 9-17-01
SCALE: 1" = 100' PRIOR INSTRUMENT: OR 430/440