
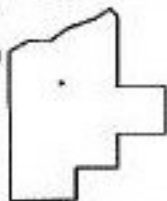


RASTER

PARENT PARCEL: 07-00-018-101-283, -282
CHILD PARCEL: 07-00-018-101-319 THRU -321
STARTING POINT: CENTERLINE OF JAYCOX RD. & O.L. 18

NO. 00870

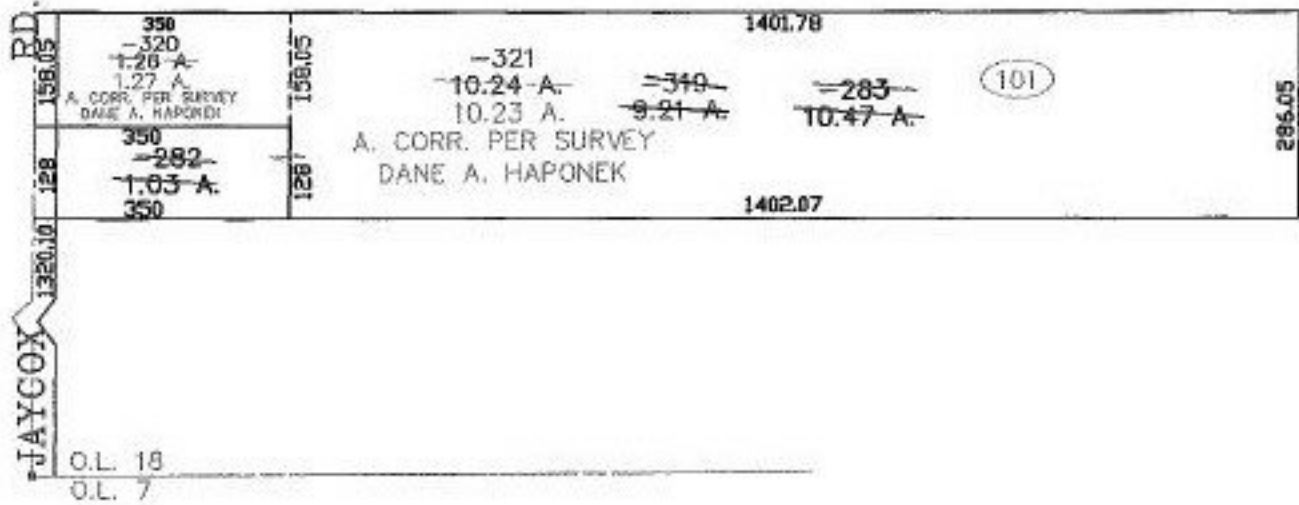

SPLITS/DEEDS PROCESSED
LORAIN COUNTY TAX MAP DEPARTMENT
226 MIDDLE AVE. ELYRIA, OHIO

SURVEYED BY: DANE A. HAPONEK
CLOSURE: 0.00 : 10.000
MAP PAGE(S): 7-00-018-C
APPROVED BY: JAH DATE: 9-18-01
SCALE: 1" = 300' PRIOR INSTRUMENT: 20010756421