


RASTER

PARENT PARCEL: 05-00-052-000-025, -026
CHILD PARCEL: 05-00-052-000-051
STARTING POINT: CENTERLINE OF OBERLIN RD. & O.L. 52

NO. 00877

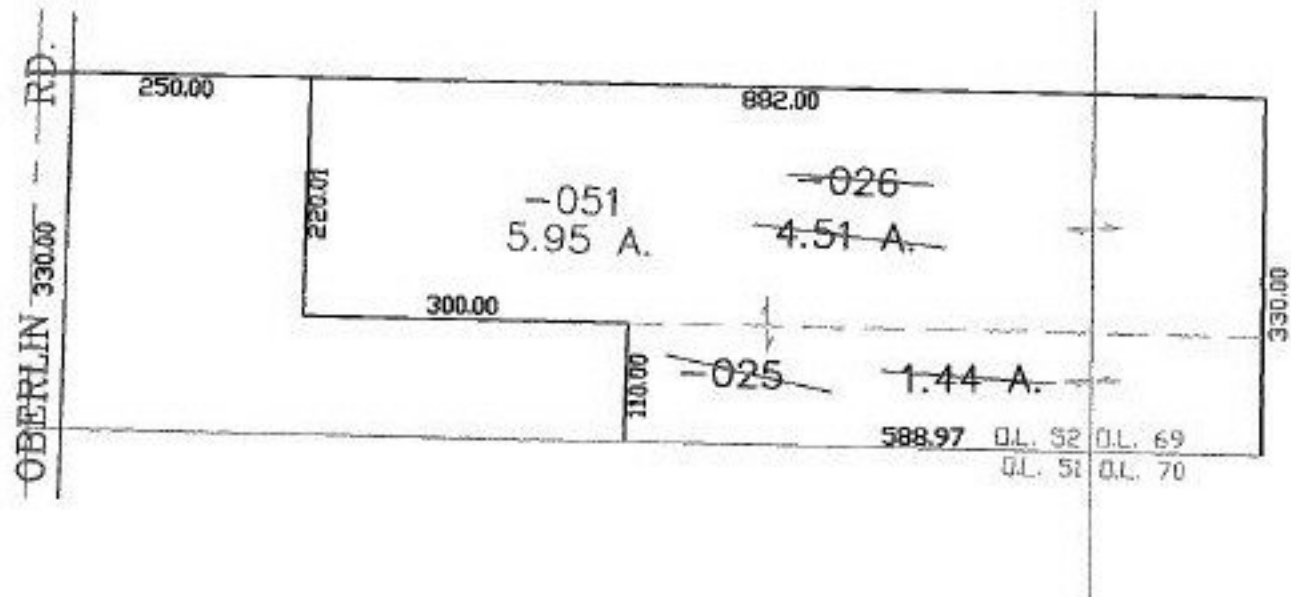

SPLITS/DEEDS PROCESSED
LORAIN COUNTY TAX MAP DEPARTMENT
226 MIDDLE AVE. ELYRIA, OHIO

SURVEYED BY: L.W. HALL
CLOSURE: 0.00 : 10.000
MAP PAGE(S): 5-G
APPROVED BY: JAH DATE: 10-10-01
SCALE: 1" = 200 PRIOR INSTRUMENT: 20010771683